

SIMPSON  
J 35  
6-26-73

MISSISSIPPI  
BOARD OF WATER COMMISSIONERS  
416 North State Street  
Jackson, Mississippi 39201

CODED

WATER WELL DRILLERS LOG

June 26 1973 J. E. Thompson Simpson  
date well completed firm name county well located

LANDOWNER:  
Lockhart Harris  
  
(mailing address)  
  
WELL LOCATION:  
sec. 34 T. 1 N. R. 24 E. S. 3  
5 miles S of Memphis  
(distance) (direction) (nearest town)

description of formations encountered	from	to
<u>Top soil</u>	<u>0</u>	<u>10</u>
<u>On top sand</u>	<u>10</u>	<u>105</u>
<u>Pl. Material</u>	<u>105</u>	<u>115</u>
<u>sand</u>	<u>115</u>	<u>170</u>

WELL PURPOSE: Domestic  
(home, irrigation, municipal, industrial)

- WELL COMPLETION DATA:
- (1) diameter (inches) 4 in
  - (2) total depth (feet) 170
  - (3) static water level (feet) 105 below/above top of ground.
  - (4) casing plastic 160 (material) (depth)  
4 in (size) if telescope see back.
  - (5) screen 105, 160 (length) (depth to top)  
4 in, plastic (size) (material)
  - (6) pump 1 1/2 (HP) 15 (yield gpm)
  - (type power)
  - (7) electric log no (yes or no)
  - (organization running log)
  - (8) how well bottom plugged


CODED

DEPT. OF WATER  
MAY 10 1974

DRILLERS REMARKS:

If well telescopes please sketch and show depths.

GROUND LEVEL

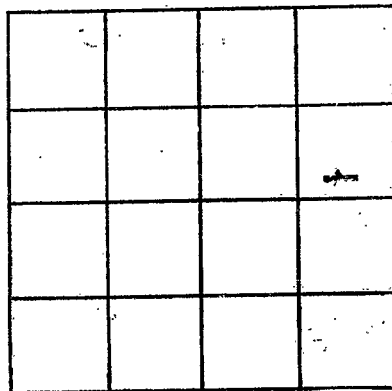

SECTION 34

Please indicate well location X.

ADDITIONAL INFORMATION

If more than one screen,  
show locations of each on sketch.