

SIMPSON
J 36
3-7-75
E Log # 173

MISSISSIPPI
BOARD OF WATER COMMISSIONERS
416 North State Street
Jackson, Mississippi 39201

WATER WELL DRILLERS LOG

3/7/75 19 W.E. Simpson Simpson
date well completed firm name county well located

LANDOWNER:
James Reeves
(mailing address)

WELL LOCATION:
sec. 2 T. 1 (N) R. 4 (E)
S W
5 miles S of Meridian
(distance) (direction) (nearest town)

WELL PURPOSE: Home
(home, irrigation, municipal, industrial)

- WELL COMPLETION DATA:
- (1) diameter (inches) 2"
 - (2) total depth (feet) 106
 - (3) static water level (feet) 67 ^{below} _{above} top of ground.
 - (4) casing Plastic, 101'
(material) (depth)
2"
(size) if telescope see back.
 - (5) screen 5', 101'
(length) (depth to top)
008, Plastic
(size) (material)
 - (6) pump 1 6
(HP) (yield gpm)
Jet
(type power)
 - (7) electric log yes
(yes or no)
M. G. S.
(organization running log)
 - (8) how well bottom plugged Blow out


description of formations encountered	from	to
<u>Top soil</u>	<u>0</u>	<u>5</u>
<u>clay sand</u>	<u>5</u>	<u>9</u>
<u>red sand</u>	<u>9</u>	<u>25</u>
<u>hard sand</u>	<u>25</u>	<u>45</u>
<u>hard sand</u>	<u>45</u>	<u>68</u>
<u>sand</u>	<u>68</u>	<u>106</u>

DRILLERS REMARKS:

RECEIVED
APR 21 1975

If well telescopes please sketch and show depths.

GROUND LEVEL

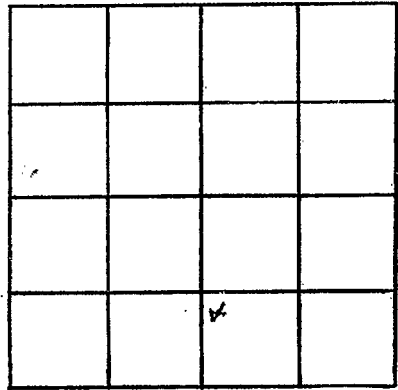

SECTION 25

Please indicate well location X.

ADDITIONAL INFORMATION

If more than one screen, show locations of each on sketch.