

SIMPSON
J37
3-12-75

MISSISSIPPI
BOARD OF WATER COMMISSIONERS
416 North State Street
Jackson, Mississippi 39201

CODED

WATER WELL DRILLERS LOG

3/12/75 19 H.E. Simpson Simpson
date well completed firm name county well located

LANDOWNER:
E. L. Smith

(mailing address)

WELL LOCATION:
sec 25 T 1 N R 4 E
S W
5 miles S of Meridian
(distance) (direction) (nearest town)

WELL PURPOSE: home
(home, irrigation, municipal, industrial)

- WELL COMPLETION DATA:
- (1) diameter (inches) 2"
 - (2) total depth (feet) 51'
 - (3) static water level (feet) 30 ^{below}/_{above} top of ground.
 - (4) casing Plastic, 46'
(material) (depth)
2"
(size) if telescope see back.
 - (5) screen 5', 46'
(length) (depth to top)
008, Plastic
(size) (material)
 - (6) pump 1 10
(HP) (yield gpm)
Jet
(type power)
 - (7) electric log no
(yes or no)
 - (organization running log)
 - (8) how well bottom plugged Well

description of formations encountered	from	to
<u>top soil</u>	<u>0</u>	<u>5</u>
<u>clay gravel</u>	<u>5</u>	<u>9</u>
<u>red sand</u>	<u>9</u>	<u>17</u>
<u>gray clay</u>	<u>17</u>	<u>20</u>
<u>gravel</u>	<u>20</u>	<u>30</u>
<u>sea gravel</u>	<u>30</u>	<u>35</u>
<u>sand</u>	<u>35</u>	<u>51</u>

CODED


RECEIVED
APR 21 1975

DRILLERS REMARKS:

MISS. BD. OF WATER COMMISSIONERS

If well telescopes please sketch and show depths.

GROUND LEVEL

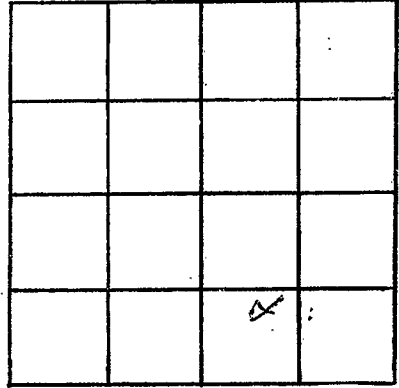

SECTION 25

Please indicate well location X.

ADDITIONAL INFORMATION

If more than one screen, show locations of each on sketch.