

MISSISSIPPI DEPARTMENT OF NATURAL RESOURCES

Bureau of Land and Water Resources

Southport Mall

P.O. Box 10631

Jackson, Mississippi 39209

WATER WELL DRILLERS LOG

CODED

Simpson
J40
2-8-78
Elog #198

1978 Jack D. Quinn

Simpson

date well completed

firm name

county well located

LANDOWNER:

Earl Krupp

(mailing address)

WELL LOCATION:

sec. 5 T. 1 N. S. R. 4 E. W.

(distance) miles (direction) of (nearest town)

WELL PURPOSE: home
(home, irrigation, municipal, industrial)

WELL COMPLETION DATA:

- (1) diameter (inches) 4"
- (2) total depth (feet) 260
- (3) static water level (feet) 90 below above top of ground.
- (4) casing POC 240
(material) (depth)
44 if telescope see back.
(size)
- (5) screen 90 240
(length) (depth to top)
40 POC
(size) (material)
- (6) pump 1 8
(HP) (yield gpm)
(type power)
- (7) electric log yes
(yes or no)
MGS
(organization running log)
- (8) how well bottom plugged

description of formations encountered

from

to

| | | |
|------------|-----|-----|
| Gravel | 0 | 50 |
| CLAY CODED | 50 | 60 |
| Gravel | 60 | 80 |
| CLAY | 80 | 180 |
| Gravel | 180 | 200 |
| CLAY | 200 | 230 |
| Gravel | 230 | 260 |

DRILLERS REMARKS:


DEPT. OF NATURAL RESOURCES
BUREAU OF LAND & WATER RESOURCES

DEC - 9 1980

RECEIVED

If well telescopes please sketch and show depths.

GROUND LEVEL

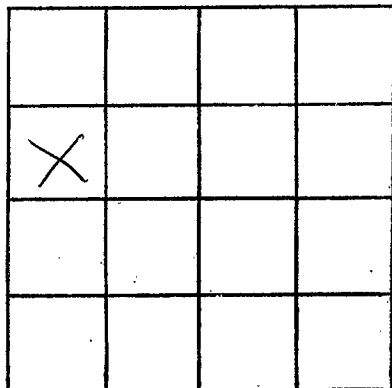

SECTION 5

Please indicate well location X.

ADDITIONAL INFORMATION

If more than one screen,
show locations of each on sketch.