

SIMPSON
 J45
 5-30-79
 Elev # 232

MISSISSIPPI
 BOARD OF WATER COMMISSIONERS
 416 North State Street
 Jackson, Mississippi 39201

CODED ✓

WATER WELL DRILLERS LOG

date well completed

firm name

county well located

5-30 1979 Guiana WATER well serv
 SIMPSON


LANDOWNER:	description of formations encountered	from	to
John Hammond	Sand	0	130
(mailing address)			
WELL LOCATION:			
sec. <u>2</u> T. <u>1</u> N. R. <u>4</u> E <u>24-</u> miles of <u> </u> (direction) (nearest town)			
WELL PURPOSE: (home, irrigation, municipal, industrial)			
WELL COMPLETION DATA:			
(1) diameter (inches) <u>4 1/2</u>			
(2) total depth (feet) <u>130</u>			
(3) static water level (feet) <u>50</u> below top of ground.			
(4) casing <u>PVC</u> <u>110'</u> below top of ground. (material) (depth)			
<u>4 1/2</u> if telescope see back. (size)			
(5) screen <u>20'</u> <u>110'</u> (length) (depth to top)			
<u>40</u> <u>PVC</u> (size) (material)			
(6) pump <u>1</u> <u>70</u> (HP) (yield gpm)			
(type power)			
(7) electric log <u> </u> (yes or no)			
<u>MOS</u> (organization running log)			
(8) how well bottom plugged <u>Bar V</u>			
DRILLERS REMARKS:			

CODED

10-3-79

If well telescopes please sketch and show depths.

GROUND LEVEL

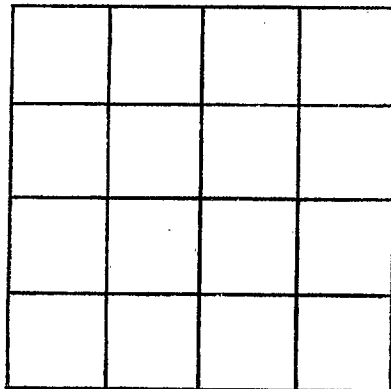

SECTION _____

Please indicate well location X.

ADDITIONAL INFORMATION

If more than one screen, show locations of each on sketch.