

SIMPSON
J 46
8-27-79

MISSISSIPPI
 BOARD OF WATER COMMISSIONERS
 416 North State Street
 Jackson, Mississippi 39201

CODED

WATER WELL DRILLERS LOG

8-27 1979 Griner Drilling Simpson

date well completed

firm name

county well located

LANDOWNER:
Pursue Energy
P.O. Box 4096
Houma, La 70361
 (mailing address)

description of formations encountered	from	to
chalk & rock	0	252
sand	252	300
chalk	300	462
sand	462	504
chalk	504	630
sand	630	668
chalk	668	798

WELL LOCATION: **1943' S 1944' E**
 sec. **17** T. **10** N R. **4** W of
 S **W/COV**
 (distance) miles (direction) of (nearest town)

WELL PURPOSE: **oil field supply**
 (home, irrigation, municipal, industrial)

CODED

WELL COMPLETION DATA:

- (1) diameter (inches) **3"**
- (2) total depth (feet) **798'**
- (3) static water level (feet) **90'** below top of ground
- (4) casing **Steel**, **304'**
 (material) (depth)
3" If telescope see back.
 (size)
- (5) screen **42'**, **262'**
 (length) (depth to top)
3", **perforated**
 (size) (material)
- (6) pump **—**, **90**
 (HP) (yield gpm)
AC
 (type power)
- (7) electric log **—**
 (yes or no)

(organization running log)

(8) how well bottom plugged **orange peel**

DRILLERS REMARKS:


Miss. Board of Water Comm.

SEP 17 1979

RECEIVED

If well telescopes please sketch and show depths.

GROUND LEVEL

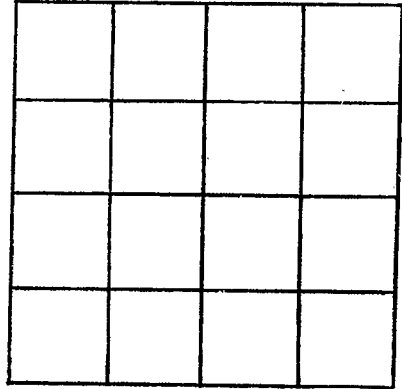

SECTION _____

Please indicate well location X.

ADDITIONAL INFORMATION

If more than one screen, show locations of each on sketch.