

SIMPSON
J 48
11/20/79

MISSISSIPPI
 BOARD OF WATER COMMISSIONERS
 416 North State Street
 Jackson, Mississippi 39201

CODED

WATER WELL DRILLERS LOG

11-20-79 Griner Drilling Simpson
 date well completed firm name county well located

LANDOWNER:

Hunt Petroleum

Houma, La

(mailing address)

WELL LOCATION: 2900'S + 1700'E

No. 1 AINSWORTH 19-T-1-N R-4E OF W.N.W. 1/4 CO.
Pinola - Marriot
 (distance) (direction) (nearest town)

WELL PURPOSE: oil field supply
 (home, irrigation, municipal, industrial)

WELL COMPLETION DATA:

- (1) diameter (inches) 3"
- (2) total depth (feet) 630'
- (3) static water level (feet) 20' below above top of ground.
- (4) casing steel 600'
 (material) (depth)
3"
 (size) if telescope see back.
- (5) screen 42' 558'
 (length) (depth to top)
3" perforated
 (size) (material)
- (6) pump — 85
 (HP) (yield gpm)
AC
 (type power)
- (7) electric log —
 (yes or no)
- (organization running log)
- (8) how well bottom plugged orange
peel

description of formations encountered

from to

<u>clay, sand, p gravel</u>	<u>0</u>	<u>21</u>
<u>clay, sand, rock</u>	<u>21</u>	<u>63</u>
<u>clay</u>	<u>63</u>	<u>84</u>
<u>clay and rock</u>	<u>84</u>	<u>210</u>
<u>clay and sand</u>	<u>210</u>	<u>225</u>
<u>sand</u>	<u>225</u>	<u>235</u>
<u>clay and sand</u>	<u>235</u>	<u>300</u>
<u>sand - rock</u>	<u>300</u>	<u>325</u>
<u>clay + sand</u>	<u>325</u>	<u>336</u>
<u>clay</u>	<u>336</u>	<u>484</u>
<u>clay and rock</u>	<u>484</u>	<u>525</u>
<u>clay and sand</u>	<u>525</u>	<u>560</u>
<u>sand</u>	<u>560</u>	<u>605</u>
<u>clay + sand</u>	<u>605</u>	<u>630</u>

DEPT. OF NATURAL RESOURCES
 BUREAU OF LAND & WATER RESOURCES


DEC 19 1979

RECEIVED

DRILLERS REMARKS:

If well telescopes please sketch and show depths.

GROUND LEVEL

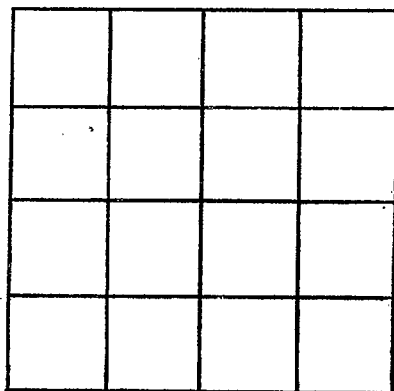

SECTION _____

Please indicate well location X.

ADDITIONAL INFORMATION

If more than one screen,
show locations of each on sketch.