

MISSISSIPPI DEPARTMENT OF NATURAL RESOURCES

Bureau of Land and Water Resources

Southport Mall

P.O. Box 10631

Jackson, Mississippi 39209

WATER WELL DRILLERS LOG

**INDEXED**

*Greene Drilling Service, Inc. Simpson*

SIMPSON  
J 51  
7-22-81

7-22-81 date well completed

Greene Drilling Service, Inc. firm name

county well located

LANDOWNER:  
*Energistics, Inc.*  
*5301 Holston Rd.*  
*Suite 490*  
*Houston, TX.* (mailing address)  
WELL LOCATION: *1500'S + 1500'E*  
*30.1 N R 4 E* of  
*James Pinola* (distance) (direction) of (nearest town)

description of formations encountered	from	to
<i>Top fill</i>	<i>0</i>	<i>21</i>
<i>clay rock</i>	<i>21</i>	<i>446</i>
<i>clay</i>	<i>446</i>	<i>609</i>
<i>straked</i>	<i>609</i>	<i>651</i>
<i>sand</i>	<i>651</i>	<i>693</i>

WELL PURPOSE: *oil field*  
*supply*  
(home, irrigation, municipal, industrial)


WELL COMPLETION DATA:

- (1) diameter (inches) *3'*
- (2) total depth (feet) *693'*
- (3) static water level (feet) *105*  below  above top of ground.
- (4) casing *steel, 693*  
(material) (depth)  
*3"*  
(size) if telescope see back.
- (5) screen *42', 651*  
(length) (depth to top)  
*3"*  
(size) *perforated*  
(material)
- (6) pump *70*  
(HP) (yield gpm)
- ac*  
(type power)
- (7) electric log  (yes or no)
- (organization running log)
- (8) how well bottom plugged *orange*  
*peel*

DEPT. OF NATURAL RESOURCES  
BUREAU OF LAND & WATER RESOURCES

AUG 26 1981


**RECEIVED**

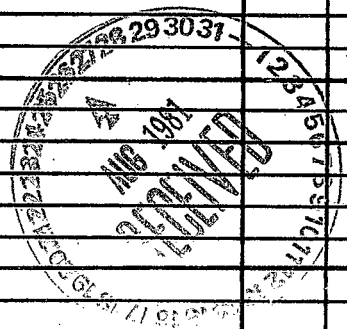

DRILLERS REMARKS:

If well telescopes please  
sketch and show depths.

GROUND LEVEL

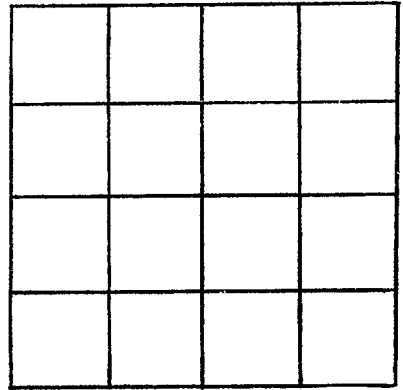

SECTION \_\_\_\_\_

Please indicate well location X.

ADDITIONAL INFORMATION

If more than one screen,  
show locations of each on sketch.