

Jimpson  
J53

MISSISSIPPI  
BOARD OF WATER COMMISSIONERS  
416 North State Street  
Jackson, Mississippi 39201

CODED

WATER WELL DRILLERS LOG

1985 3-4 85 Cooper well ser Jimpson  
date well completed firm name county well located

LANDOWNER:

Strand

(mailing address)

description of formations encountered

from to

<u>Land</u>	<u>0</u>	<u>30</u>
<u>SAND CLAY</u>	<u>30</u>	<u>100</u>
<u>SAND</u>	<u>100</u>	<u>150</u>

WELL LOCATION:

sec. 23 T L N S R 4 E W

\_\_\_\_\_ miles \_\_\_\_\_ of \_\_\_\_\_  
(distance) (direction) (nearest town)

WELL PURPOSE:

(home, irrigation, municipal, industrial)

WELL COMPLETION DATA:

- (1) diameter (inches) 4"
- (2) total depth (feet) 150
- (3) static water level (feet) 40 below above top of ground.
- (4) casing PVC 130'  
(material) (depth)  
4"  
(size) If telescope see back.
- (5) screen 20' 130'  
(length) (depth to top)  
4" PVC  
(size) (material)
- (6) pump 1 10  
(HP) (yield gpm)

(type power)

- (7) electric log yes (yes or no)

MGS  
(organization running log)

- (8) how well bottom plugged plug

DRILLERS REMARKS:

CODED


RECEIVED

JUN 25 1986

Department of Natural Resources  
Bureau of Land & Water Resources

If well telescopes please  
sketch and show depths.

GROUND LEVEL

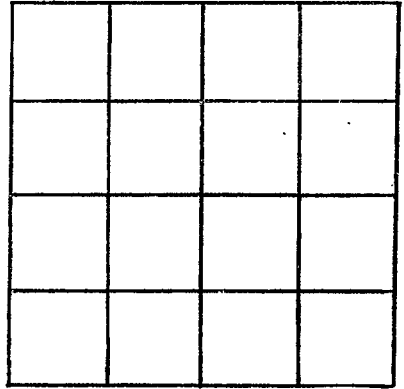

SECTION \_\_\_\_\_

Please indicate well location X.

ADDITIONAL INFORMATION

If more than one screen,  
show locations of each on sketch.