

SIMPSON Co.

J58

6-20-83

Log # 298

6-20

date well completed

MISSISSIPPI BOARD OF WATER COMMISSIONERS
416 North State Street
Jackson, Mississippi 39201

CODED

WATER WELL DRILLERS LOG

1983 Gunn well ser

SIMPSON

firm name

county well located

LANDOWNER:

L. McCoy

(mailing address)

description of formations encountered

from

to

clay
clay
sand

0 60
100 70
10 140

CODED

WELL LOCATION:

sec. 22 T 1 N R 4 E
5 S W

miles (distance) of (direction) (nearest town)

WELL PURPOSE:

(home, irrigation, municipal, industrial)

WELL COMPLETION DATA:

- (1) diameter (inches) 4 1/2
- (2) total depth (feet) 140
- (3) static water level (feet) 100 below above-top of ground.
- (4) casing PVC 120
(material) (depth)
- 4 if telescope see back.
(size)
- (5) screen 20 120
(length) (depth to top)
- 4 PVC
(size) (material)
- (6) pump 1 100
(HP) (yield gpm)

(type power)

(7) electric log (yes or no)

(organization running log)

(8) how well bottom plugged Beu

DRILLERS REMARKS:


DEPT. OF NATURAL RESOURCES
BUREAU OF LAND & WATER RESOURCES

NOV -7 1983

RECEIVED

If well telescopes please sketch and show depths.

GROUND LEVEL

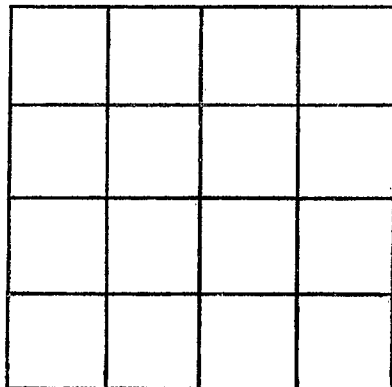

SECTION _____

Please indicate well location X.

ADDITIONAL INFORMATION

If more than one screen,
show locations of each on sketch.