

MISSISSIPPI DEPARTMENT OF ENVIRONMENTAL QUALITY
Bureau of Land and Water Resources

P. O. Box 10631
Jackson, MS 39289-0631
WATER WELL DRILLERS LOG

COUNTY WELL LOCATED Simpson	
WELL NUMBER Attie Job	CODED <input checked="" type="checkbox"/>
Magee #3	
DATE WELL COMPLETED 7-29-92	

PERMIT NUMBER 0-453
NAME OF DRILLING FIRM Morphis Brothers Inc.
Trout, La 71371

NAME & MAILING ADDRESS OF LANDOWNER Justiss Oil Company			
P.O. Box 1385			
Jena, La 71342			
WELL LOCATION	SEC	TOWNSHIP	RANGE
	17	1	4
		N	E
		S	W
DISTANCE	DIRECTION	NEAREST TOWN	
3.5 Miles	NE	of Pinola	
OTHER LANDMARK 1650' N & 330' E OF SW/40R.			
WELL PURPOSE: Home, Irrigation, Municipal, Industrial, Fish Pond, etc. Rig Supply			

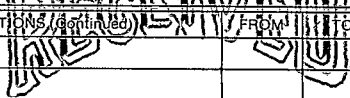
PUMP DATA		
PUMP TYPE (Circle One): <input checked="" type="checkbox"/> Submersible Turbine, Jet, Flowing Well, Other (Describe) _____		
POWER TYPE (Circle One): <input checked="" type="checkbox"/> Electric Tractor, Diesel, Gasoline, Butane, Other (Describe) 5 H/P _____		
Pump Capacity (GPM) 55	No. of Stages	Setting Depth FT.
PUMP TEST		
Well yielded 60 GPM with a drawdown of _____ ft. after _____ hours of pumping		

WELL DATA		
Well Depth 330	Casing Diameter (In.) 4	Casing Length (Ft.) 312
Type of Casing PVC	Hole Depth 330	Depth to Static Water Level 70
TYPE OF COMPLETION: (Circle One or More): <input checked="" type="checkbox"/> Gravel Packed, Underreamed, Telescoped, Natural Development, Open Hole, Other (Describe) _____		
Top of Lap Pipe or Reduction in Casing FEET IF TELESCOPED OR MORE THAN ONE SCREEN: USE BACK PAGE		

LOG DATA	
TYPE OF LOG RUN (Circle One): No Log Run, Electric, Gamma Ray, Density, Sonic, Neutron, Other (Describe) _____	
Name of Organization Running Log	

SCREEN DATA		
Diameter - Inches 4	Length - Feet 20	Slot Size - Inches .013
Screen Type PVC	Depth to Bottom - Feet 0	

GEOLOGIC DATA (Office Use Only)			
Surface Elev.	Geologic Unit	Unit Thickness	Depth to Top
Subs. SWL	Date	Analysis	Aquifer Test
Driller's Remarks Casing extends 2 feet above ground level			

DESCRIPTION OF FORMATIONS ENCOUNTERED	FROM	TO	FORMATIONS (continued)	FROM	TO
Gray Clay	0	20	 AUG 31 1992 Dept. of Environmental Quality Bureau of Land & Water Resources		
Gray Clay	20	40			
Blue, Gray & Brown Clay	40	80			
Clay & Silty Sand	80	100			
Red, Brown, Clay	100	120			
Blue & Gray Clay	120	200			
Sandy Clay	200	240			
Sandy Gray Clay	240	280			
Fine Gray & White Sand	280	300			
Coarse White Sand	300	315			
Coarse White Sand	315	330			

IF MORE SPACE IS NEEDED, USE BACK

If well telescopes please
sketch and show depths.

GROUND LEVEL

SECTION _____

Please indicate well location X.

ADDITIONAL INFORMATION

If more than one screen,
show location of each on sketch.