

State Well Report

Part 1

Mississippi Department of Environmental Quality
Office of Land and Water Resources
P.O. Box 10631
Jackson, MS 39289-0631
(601)961-5210
(601)354-6938 (fax)

For Office Use Only:

Aquifer: _____
Well #: 2-93 127
L. S. Elevation: _____
E-log #: _____

County: Simpson
Permit #: _____
Driller: James Wells
Date drilling completed: 12-1-04

State Law requires that this report be prepared by the driller in detail and filed with the Department within 30 days of completion of drilling of the well.

Well Owner Information	Well Location
Owner Name: <u>Curtis McMiller</u>	Latitude: _____ Longitude: _____
Mailing Address: <u>P.O. Box 338</u> <u>Mendenhall MS 39114</u>	Method of Lat/Long (circle one): Conventional Survey, USGS quad, Hand-held GPS, Survey-grade GPS
City: _____ State: _____ Zip Code: _____	<u>E 1/4 N 1/4 Sec 4</u> Twn <u>4E</u> Rng <u>4E</u>
Telephone No. <u>(601) 847-1951</u>	Distance _____ Direction <u>SW</u> of Nearest Town <u>Mendenhall</u>

Well Data

Purpose of Well (circle one) Home Industrial Public Supply Irrigation Fish Culture Other: _____

Date well drilling started: 12-1-04 Date well drilling completed: 12-1-04

If flowing, method of flow regulation: Valve _____ Other (describe) _____

Static Water Level: 140 feet above or below (circle one) land surface Date measured: 12-1-04

Method of Measurement (circle one) steel tape ~~electric tape~~ air line other: _____

Hole depth: 390 Well depth: 390 Well grouted to a depth of 10 feet

Type of grout (circle one): Cement Bentonite Mix

Casing length: 360 feet Casing diameter: 4 inches Type of casing: PVC

Screen length: 30 feet Screen diameter: 4 inches Type of screen: PVC

Screen slot size: 002 inches Setting depth: From 360 feet to 390 feet

Type of completion (circle all applicable): Gravel packed Underreamed Telescoped Open hole Natural Development

Other (describe): _____

Top of lap pipe or reduction in casing: _____ feet. If telescoped or more than one screen, describe on back of page

Logs run (circle all applicable): No log run Electric Gamma Ray Density Sonic Neutron Other: _____

Name of organization running log(s): _____

I certify that the well was drilled, constructed, and completed in accordance with all applicable requirements of the Mississippi Department of Environmental Quality and/or the Mississippi Department of Health regulations and state laws.

JAMES WELLS D-586 James Wells
Print Name of Water Well Contractor and License No. Signature of Water Well Contractor

RECEIVED
JAN 06 2005
BY: OLWR

If well telescopes please sketch below and show depths.

127

Ground Level

J-93


Description of Formations Encountered

From To

Description of Formations Encountered	From	To
Top Soil	0	1
Red clay	1	30
Sand	30	40
Clay	40	320
Sand	320	390

If more than one screen, show location of each on sketch

Sketch the property layout and include the following: 1) the well location; 2) any permanent structures on the property that may aid in locating the well; 3) any roads, power lines, or other items that may aid in locating the property and the well; 4) indicate direction.

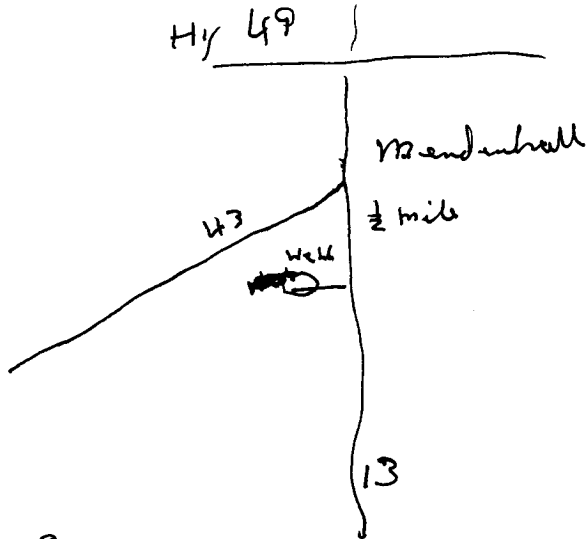

Landowner Name: Curtis Mcmill

James Wells
Signature of Water Well Contractor

RECEIVED
JAN 06 2005
BY: OLWR

STATE WELL REPORT

Part 2

Pump Installer's Completion Report
 Mississippi Department of Environmental Quality
 Office of Land and Water Resources
 P.O. Box 10631
 Jackson, MS 39289-0631
 (601)961-5210
 (601)354-6938 (fax)

For Office Use Only:

Aquifer: _____

Well #: J-93 127

Elevation: _____

County: Simpson
 Permit #: _____
 Driller: James Wells
 Date completed: 12-1-04

This report should be prepared by the pump installer in detail and filed with the Department within 30 days of the installation of pump.

Well Owner Information	Well Location
Owner Name: <u>Curtis McMillin</u>	Latitude: _____ Longitude: _____
Mailing Address: <u>P.O. Box 338</u>	Method of Lat/Long (circle one): <input type="radio"/> Conventional Survey,
<u>Mendenhall MS 39114</u>	<input type="radio"/> USGS quad, <input type="radio"/> Hand-held GPS, <input type="radio"/> Survey-grade GPS
City _____ State _____ Zip Code _____	<input type="radio"/> 1/4 _____ 1/4 Sec <u>4</u> Twn <u>4E</u> Rng <u>1N</u>
Telephone No. <u>(601) 847-1951</u>	Distance _____ Direction _____ Nearest Town _____
	<u>1</u> Miles <u>SW</u> of <u>Mendenhall</u>

Pump Type Circle one	Power Type Circle one
Air Lift <input type="radio"/> Jet <input type="radio"/> <u>Submersible</u>	Diesel Engine <input type="radio"/> Gasoline Engine <input type="radio"/> Natural Gas <input type="radio"/>
Bucket <input type="radio"/> Piston <input type="radio"/> Turbine <input type="radio"/>	<u>Electric Motor</u> <input type="radio"/> Hand <input type="radio"/> Tractor PTO <input type="radio"/>
Centrifugal <input type="radio"/> Rotary <input type="radio"/> Flowing Well <input type="radio"/>	Windmill <input type="radio"/> Other (specify): _____
Other (specify): _____	Horse Power Rating of Motor: <u>1 1/2</u>
Date Pump Installed: <u>12-1-04</u>	Setting Depth: <u>200</u> feet
Rated Pump Capacity: <u>25</u> Gallons Per Minute	Number of Stages: <u>11</u>

Pump Test Data	Method of Measuring Water Level Circle one
Date Well Tested: _____	Air Line <input type="radio"/> Electric Measuring Line <input type="radio"/> <u>Steel Tape</u>
Static Water Level (A): <u>140</u> Feet Below Land Surface	Other (specify): _____
Pumping Water Level (B): <u>204</u> Feet Below Land Surface	For flowing well, measured shut in head: _____ feet
Drawdown [(B) - (A)]: <u>140</u> Feet Below Land Surface	Well yielded <u>25</u> GPM with a drawdown of
Test Pumping Rate: <u>25</u> Gallons Per Minute	<u>140</u> feet after <u>4</u> hours of pumping
Duration of Pump Test (minimum 4 hours): <u>4</u> hours	

I HEREBY CERTIFY that the above statements are true to the best of my knowledge.

JAMES WELLS 0586 James Wells
 Print Name of Pump Installer and License No. (if applicable) Signature of Pump Installer

RECEIVED
 JAN 06 2005
 BY: OLWR