

County: Simpson
 Permit #: _____
 Driller: Travis Boone
 Date drilling completed: 4-19-05

State Well Report

Part I

Mississippi Department of Environmental Quality
 Office of Land and Water Resources
 P.O. Box 10631
 Jackson, MS 39289-0631
 (601)961-5210
 (601)354-6938 (fax)


For Office Use Only:
 Aquifer: _____
 Well #: J-96
 L.S. Elevation: _____
 E-log #: _____

State Law requires that this report be prepared by the driller in detail and filed with the Department within 30 days of completion of drilling of the well.

Well Owner Information		Well Location	
Owner Name: <u>Doni Muebles</u>	Latitude: _____ " Longitude: _____ "	Method of Lat/Long (circle one): Conventional Survey, USGS quad, Hand-held GPS, Survey-grade GPS	
Mailing Address: <u>Jeff Alexander Rd</u> <u>D'Lo, MS 39062</u> <u>601-291-2406</u>	City: _____ State: _____ Zip Code: _____	Distance _____ 1/4 _____ 1/4 Sec <u>6</u> Twn <u>1N</u> Rng <u>4E</u>	
Telephone No. () _____	Distance _____ Miles	Direction <u>SW</u>	Nearest Town <u>D'LO</u>
Well Data			
Purpose of Well (circle one) <u>Home</u> Industrial Public Supply Irrigation Fish Culture Other: _____			
Date well drilling started: <u>4-19-05</u>		Date well drilling completed: <u>4-19-05</u>	
If flowing, method of flow regulation: Valve _____ Other (describe) _____			
Static Water Level: <u>180</u> feet above or below (circle one) land surface		Date measured: <u>4-19-05</u>	
Method of Measurement (circle one) steel tape electric tape air line other: <u>string line</u>			
Hole depth: _____ Well depth: <u>255</u>		Well grouted to a depth of <u>10</u> feet	
Type of grout (circle one): <u>Cement</u> Bentonite Mix			
Casing length: <u>235</u> feet	Casing diameter: <u>4</u> inches	Type of casing: <u>sch 40</u>	
Screen length: <u>20</u> feet	Screen diameter: <u>4</u> inches	Type of screen: <u>sch 40</u>	
Screen slot size: <u>8</u> inches	Setting depth: From <u>235</u> feet to <u>255</u> feet		
Type of completion (circle all applicable): <u>Gravel packed</u> Underreamed Telescoped Open hole Natural Development			
Other (describe): _____			
Top of lap pipe or reduction in casing: _____ feet. If telescoped or more than one screen, describe on back of page			
Logs run (circle all applicable) <u>No log run</u> Electric Gamma Ray Density Sonic Neutron Other: _____			
Name of organization running log(s): _____			
I certify that the well was drilled, constructed, and completed in accordance with all applicable requirements of the Mississippi Department of Environmental Quality and/or the Mississippi Department of Health regulations and state laws.			
Print Name of Water Well Contractor and License No. <u>TRAVIS BOONE 0-514</u>		Signature of Water Well Contractor <u>Travis Boone</u>	

If well telescopes please sketch below and show depths.

Ground Level

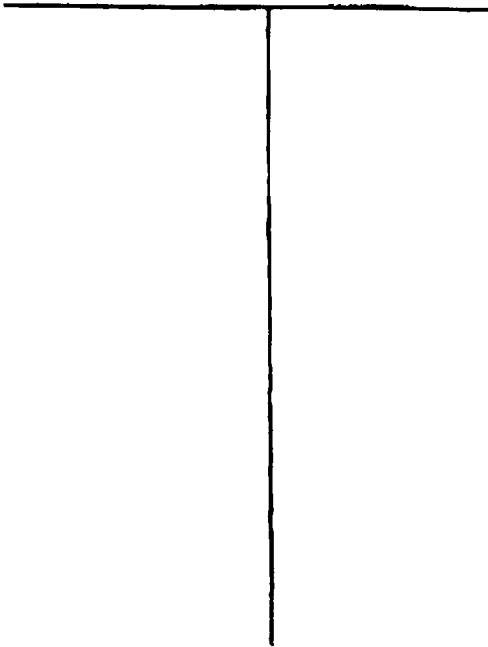

J-96

Description of Formations Encountered	From	To
Clay	0	30
rock sand	30	45
rock	45	50
Clay	50	115
rock	115	123
Clay	123	160
rock	160	168
Clay	168	230
sand	230	250

If more than one screen, show location of each on sketch

Sketch the property layout and include the following: 1) the well location; 2) any permanent structures on the property that may aid in locating the well; 3) any roads, power lines, or other items that may aid in locating the property and the well; 4) indicate direction.

speed way

well

Landowner Name: Don Strubbs

Ann's Beane
Signature of Water Well Contractor

STATE WELL REPORT

Part 2

Pump Installer's Completion Report
 Mississippi Department of Environmental Quality
 Office of Land and Water Resources
 P.O. Box 10631
 Jackson, MS 39289-0631
 (601)961-5210
 (601)354-6938 (fax)

For Office Use Only

Aquifer: _____

Well #: J-96

Elevation: _____

County: Simpson
 Permit #: _____
 Driller: Jarvis Boone
 Date completed: 4-19-05

This report should be prepared by the pump installer in detail and filed with the Department within 30 days of the installation of pump.

Well Owner Information	Well Location
Owner Name: <u>Don Mubbs</u>	Latitude: _____ Longitude: _____
Mailing Address: <u>Jeff Alexander Rd.</u> <u>D'LO, Ms 39062</u>	Method of Lat/Long (circle one): <input type="radio"/> Conventional Survey, <input type="radio"/> USGS quad, <input type="radio"/> Hand-held GPS, <input type="radio"/> Survey-grade GPS
City _____ State _____ Zip Code _____	<u>1/4</u> _____ <u>1/4</u> Sec. <u>6</u> Twn. <u>1N</u> Rng. <u>4E</u>
Telephone No. (601) <u>291-2406</u>	Distance _____ Direction _____ Nearest Town _____ <u>3</u> Miles <u>SW</u> of <u>D'LO</u>

Pump Type Circle one	Power Type Circle one
Air Lift <input type="checkbox"/> Jet <input type="checkbox"/> <input checked="" type="radio"/> <u>Submersible</u>	Diesel Engine <input type="checkbox"/> Gasoline Engine <input type="checkbox"/> Natural Gas <input type="checkbox"/>
Bucket <input type="checkbox"/> Piston <input type="checkbox"/> Turbine <input type="checkbox"/>	<input checked="" type="radio"/> <u>Electric Motor</u> <input type="checkbox"/> Hand <input type="checkbox"/> Tractor PTO
Centrifugal <input type="checkbox"/> Rotary <input type="checkbox"/> Flowing Well <input type="checkbox"/>	Windmill <input type="checkbox"/> Other (specify): _____
Other (specify): _____	Horse Power Rating of Motor: <u>1</u>
Date Pump Installed: <u>4-19-05</u>	Setting Depth: <u>220</u> feet
Rated Pump Capacity: _____ Gallons Per Minute	Number of Stages: _____

Pump Test Data	Method of Measuring Water Level Circle one
Date Well Tested: <u>4-19-05</u>	Air Line <input type="checkbox"/> Electric Measuring Line <input type="checkbox"/> Steel Tape <input type="checkbox"/>
Static Water Level (A): <u>180</u> Feet Below Land Surface	Other (specify): <u>string line</u>
Pumping Water Level (B): _____ Feet Below Land Surface	For flowing well, measured shut in head: _____ feet
Drawdown ((B) - (A)): _____ Feet Below Land Surface	Well yielded _____ GPM with a drawdown of _____ feet after _____ hours of pumping
Test Pumping Rate: _____ Gallons Per Minute	
Duration of Pump Test (minimum 4 hours): _____ hours	

I HEREBY CERTIFY that the above statements are true to the best of my knowledge.

Jarvis Boone 0-514 _____
 Print Name of Pump Installer and License No. (if applicable) Signature of Pump Installer