

EL. 89

MISSISSIPPI  
BOARD OF WATER COMMISSIONERS  
416 North State Street  
Jackson, Mississippi 39201

CODED

WATER WELL DRILLERS LOG

Simpson  
K 7  
6-68  
Elec Log # 89  
6-24 1968  
date well completed

Laurel-Central Co. Simpson  
firm name county well located

LANDOWNER: Smith Crossing  
Water Association  
Magee, Mississippi  
(mailing address)  
WELL LOCATION: NW NW SE  
sec. 35 T 1 N R 5 E  
S W  
(distance) miles (direction) of (nearest town)

description of formations encountered	from	to
Red Clay	0	9
yellow sand + Clay	9	44
Sand	44	135
Clay	135	158
sandy Clay	158	207
Brittle Clay & Gravel	207	224
Sandy Clay	224	312

WELL PURPOSE: Domestic  
(home, irrigation, municipal, industrial)

WELL COMPLETION DATA:  
(1) diameter (inches) 18" x 10"  
(2) total depth (feet) 130'  
(3) static water level (feet) 54' below top of ground.  
(4) casing Steel, 90' 2.18" (material) (depth)  
103' 2.10" (size) if telescope see back.  
(5) screen 20' (length), 105' (depth to top)  
8" (size), Stainless Steel (material)  
(6) pump 15 (HP) (yield gpm)  
Electric (type power)  
(7) electric log Yes (yds or no)  
Y.S.G.S. (organization running log)  
(8) how well bottom plugged Valve

CODED

JUL - 2 1968


MISS. BOARD OF WATER COMM.

DRILLERS REMARKS:  
Pump not installed as of this date - capacity test not run.



If well telescopes please  
sketch and show depths.

GROUND LEVEL

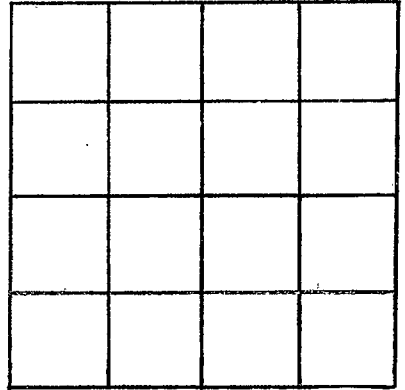

SECTION \_\_\_\_\_

Please indicate well location X.

ADDITIONAL INFORMATION

If more than one screen,  
show locations of each on sketch.