

SIMPSON  
K8  
9-66

MISSISSIPPI  
BOARD OF WATER COMMISSIONERS  
416 North State Street  
Jackson, Mississippi 39201

CODED

WATER WELL DRILLERS LOG

Sept. 15-66 19 W. H. Dallas's Well Repair Simpson  
date well completed firm name county well located

LANDOWNER:  
Lesard Mc Intech  
Rt. Magee  
(mailing address)

description of formations encountered	from	to
<del>red clay</del>	<del>0</del>	<del>25</del>
<del>red sand</del>	<del>25</del>	<del>63</del>
<del>water sand</del>	<del>63</del>	<del>71</del>
red clay	0	25
red sand	25	63
chalk	63	71
water sand	71	88

WELL LOCATION:  
sec. 21 T-1 N R-5 E  
S W  
\_\_\_\_\_ miles N of Magee  
(distance) (direction) (nearest town)

WELL PURPOSE:  
(home, irrigation, municipal, industrial)

WELL COMPLETION DATA:

(1) diameter (inches) 2 in

(2) total depth (feet) 88

(3) static water level (feet) 71 below above top of ground.

(4) casing NONE  
(material) (depth)

\_\_\_\_\_ if telescope see back.  
(size)

(5) screen 6 ft \_\_\_\_\_  
(length) (depth to top)

1/4 \_\_\_\_\_  
(size) (material) Brass

(6) pump 1/2 \_\_\_\_\_  
(HP) (yield gpm)

\_\_\_\_\_ (type power)

(7) electric log No  
(yes of no)

\_\_\_\_\_ (organization running log)

(8) how well bottom plugged \_\_\_\_\_


CODED

MISSISSIPPI  
BOARD OF  
WATER COMMISSIONERS  
AUG 19 1966

DRILLERS REMARKS:

If well telescopes please sketch and show depths.

GROUND LEVEL

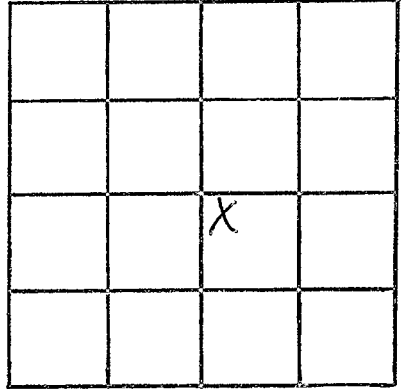

SECTION \_\_\_\_\_

Please indicate well location X.

ADDITIONAL INFORMATION

Lined area for additional information.

If more than one screen, show locations of each on sketch.