

SIMPSON  
K10  
5-68

MISSISSIPPI  
BOARD OF WATER COMMISSIONERS  
416 North State Street  
Jackson, Mississippi 39201

CODED

WATER WELL DRILLERS LOG


May 16 1968 Thompson & Wells Simpson  
date well completed firm name county well located

LANDOWNER: <u>Doc S.</u>	description of formations encountered	from	to
<u>Highway</u> <u>Law</u> (mailing address)			
WELL LOCATION: sec. <u>21</u> T <u>1</u> N R <u>5</u> E <u>2 1/2</u> miles <u>SW</u> of <u>Sumner</u> (distance) (direction) (nearest town)	<u>clay</u>	<u>0</u>	<u>10</u>
WELL PURPOSE: <u>Home</u> (home, irrigation, municipal, industrial)	<u>hard rock</u>	<u>10</u>	<u>85</u>
WELL COMPLETION DATA: (1) diameter (inches) <u>2"</u>	<u>bracket</u>	<u>85</u>	<u>105</u>
(2) total depth (feet) <u>121'</u>	<u>bracket</u>	<u>105</u>	<u>121</u>
(3) static water level (feet) <u>85'</u> below above top of ground.			
(4) casing <u>gal.</u> <u>118'</u> (material) (depth) <u>2"</u> if telescope see back. (size)			
(5) screen <u>3'</u> <u>118'</u> (length) (depth to top) <u>2"</u> <u>Plastic</u> (size) (material)			
(6) pump <u>3/4 HP</u> <u>4 1/2</u> (HP) (yield gpm) <u>rod pump</u> (type power)			
(7) electric log <u>no</u> (yes or no) (organization running log)			
(8) how well bottom plugged <u>bracket</u>			
DRILLERS REMARKS:			

JUN 11 1968  
MISS. BOARD OF  
WATER COMMISSIONERS

If well telescopes please sketch and show depths.

GROUND LEVEL

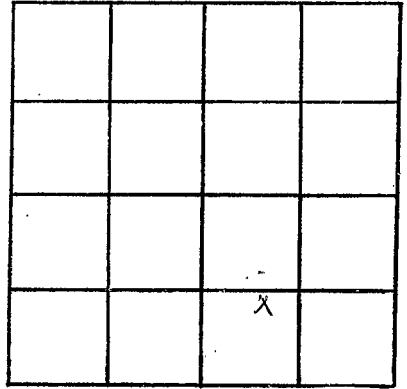

SECTION 21

Please indicate well location X.

ADDITIONAL INFORMATION

If more than one screen,  
show locations of each on sketch.