

76
 SIMPSON
 K14
 2-2-62

CODED
 R

WATER WELL DRILLERS LOG

Date: 2/2, 1962, Driller: [Signature] County: Simpson
 (Name)

(1) Owner of Land: <u>Phillips oil Co</u> (Name)	Description & Color of Materials Sand, Clay, Red Clay, Shell, etc.	Thick- ness Feet	Depth Feet
<u>Morgan Miss</u> (Address)	<u>Red Clay</u>	15	15
(2) Location: <u>1/4, 1/4, Sec 34 T1 R5</u>	<u>Red Clay & gravel</u>	115	60
<u>1</u> miles <u>N</u> , of <u>Morgan</u> (distance) (direction) (Nearest Town)	<u>White Sand</u>	15	75
(3) Topography: <u>X</u> (Hilly) (Flat) (Level)	<u>weathered Sand</u>	17	92
(4) Purpose of Well: (Domestic Irrigation Municipal, Industrial, Other)			

Information upon completion of well:


- (1) Diameter 2 inches.
- (2) Total Depth 92 feet.
- (3) Water Level 75 feet below top of ground.
- (4) Cased to 78, Size 2".
- (5) Screen: Size 1 1/2", Length 5 ft.
- (6) Were any formations sealed against pollution?
 yes, no.

If YES depth of formation _____

Why _____

Drillers Remarks: _____

CODED

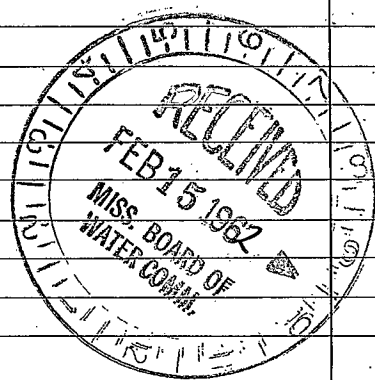

(Use Back Side)

Well No.

