

SIMPSON
K 16
5-67

MISSISSIPPI
BOARD OF WATER COMMISSIONERS
416 North State Street
Jackson, Mississippi 39201

CODED

WATER WELL DRILLERS LOG

May 17 19 67 W.H. Dallas Walk Repair Simpson
date well completed firm name county well located

LANDOWNER:
Charlottie Stenersen
Weathersby
(mailing address)

description of formations encountered	from	to
Clay	0	20
Sand	20	90
Water sand	90	113

WELL LOCATION:
sec. 5 T. 1 N. R. 5 E.
S W
miles N of Weathersby
(distance) (direction) (nearest town)

WELL PURPOSE:
(home, irrigation, municipal, industrial)

WELL COMPLETION DATA:

(1) diameter (inches) 3 in

(2) total depth (feet) 113

(3) static water level (feet) 80 below top of ground.

(4) casing Plastic 20 (material), (depth)

_____ if telescope see back. (size)

(5) screen 6 23 (length), (depth to top)

1 1/4 8 slot Brass (size), (material)

(6) pump 1 (HP), (yield gpm)

_____ (type power)

(7) electric log No (yes or no)

_____ (organization running log)

(8) how well bottom plugged _____


CODED

APR 2 1968
MISS. BOARD OF
WATER COMM.

DRILLERS REMARKS:

If well telescopes please sketch and show depths.

GROUND LEVEL

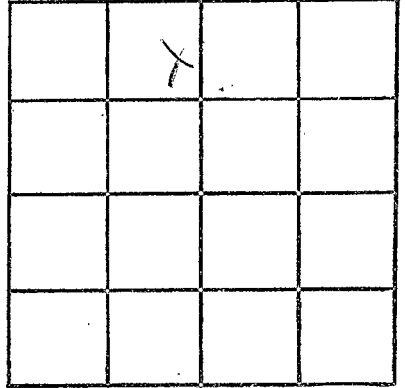

SECTION _____

Please indicate well location X.

ADDITIONAL INFORMATION

If more than one screen,
show locations of each on sketch.