

*SIMPSON*  
*K 18*  
*8-68*

MISSISSIPPI  
 BOARD OF WATER COMMISSIONERS  
 416 North State Street  
 Jackson, Mississippi 39201


CODED  
 CODED

WATER WELL DRILLERS LOG

*Aug 12* 19*68* *H. E. Thompson* *Leflore*  
 date well completed firm name county well located


LANDOWNER: <i>B. ...</i>	description of formations encountered	from	to
<i>...</i>	<i>...</i>	<i>0</i>	<i>8</i>
<i>...</i> (mailing address)	<i>...</i>	<i>8</i>	<i>25</i>
WELL LOCATION: sec. <i>14</i> T. <i>11</i> N. R. <i>5</i> E. <i>4</i> miles <i>77</i> of <i>...</i> (distance) (direction) (nearest town)	<i>...</i>	<i>3.3</i>	<i>50</i>
WELL PURPOSE: <i>...</i> (home, irrigation, municipal, industrial)			
WELL COMPLETION DATA:			
(1) diameter (inches) <i>2"</i>			
(2) total depth (feet) <i>75</i>			
(3) static water level (feet) <i>57</i> below/above top of ground.			
(4) casing <i>Gal</i> <i>72'</i> (material) (depth) <i>2"</i> (size) if telescope see back.			
(5) screen <i>...</i> <i>73'</i> (length) (depth to top) <i>2"</i> (size) (material)			
(6) pump <i>3/4</i> <i>6</i> (HP) (yield gpm) <i>...</i> (type power)			
(7) electric log <i>...</i> (yes or no) <i>...</i> (organization running log)			
(8) how well bottom plugged <i>...</i>			
DRILLERS REMARKS:			

CODED

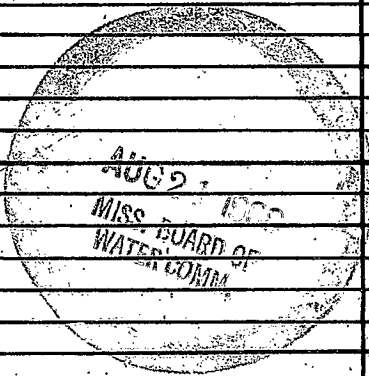

If well telescopes please sketch and show depths.

GROUND LEVEL

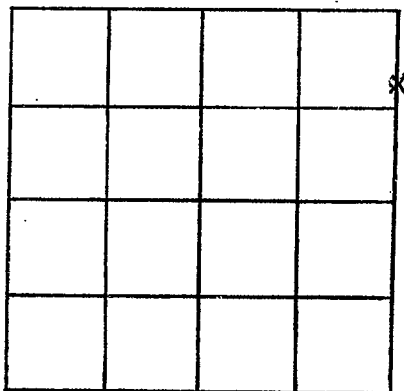

SECTION 14

Please indicate well location X.

ADDITIONAL INFORMATION

If more than one screen, show locations of each on sketch.