

Simpson
 K20
 12-69

MISSISSIPPI
 BOARD OF WATER COMMISSIONERS
 416 North State Street
 Jackson, Mississippi 39201

CODED

WATER WELL DRILLERS LOG

1969 McWilliams, UWS Simpson

date well completed

firm name

county well located

LANDOWNER: MRS ALTA B.
 WAMACR RT4,
 MEMPHIS MISS
 (mailing address)

description of formations encountered	from	to
CLAY	0	14
SAND	14	20
GRAVEL	20	42
SAND	42	50
GRAVEL	50	65
WATER SAND	65	84

WELL LOCATION:

sec. 12 T. 1 N R. 5 E
 S W
 5 miles N of MACRE
 (distance) (direction) (nearest town)

WELL PURPOSE: HOME
 (home, irrigation, municipal, industrial)

WELL COMPLETION DATA:

- (1) diameter (inches) 2"
- (2) total depth (feet) 84
- (3) static water level (feet) 65 below top of ground.
- (4) casing GRAVEL (material), 79 (depth)
 (size) if telescope see back.
- (5) screen 5 FT (length), (depth to top)
 1 1/4 BRONZE (size) (material)
- (6) pump 1 (HP), 430 (yield gpm)
 ELECT (type power)
- (7) electric log NO (yes or no)
- (organization running log)

(8) how well bottom plugged


JAN 5 1970

DRILLERS REMARKS:

MISS. BD. OF
 WATER COMM.

If well telescopes please sketch and show depths.

GROUND LEVEL

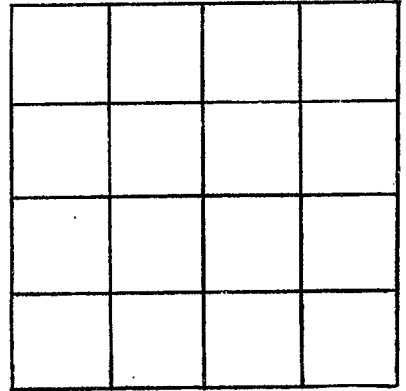

SECTION 12

Please indicate well location X.

ADDITIONAL INFORMATION

A series of 20 horizontal lines for recording additional information.

If more than one screen, show locations of each on sketch.