

MISSISSIPPI
BOARD OF WATER COMMISSIONERS
416 North State Street
Jackson, Mississippi 39201

CODED

WATER WELL DRILLERS LOG

SIMPSON
K 22
8-21-70

Aug 21 1970 G. E. Simpson Well Simpson
date well completed firm name county well located

LANDOWNER:	description of formations encountered	from	to
William Simpson Magnolia Miss. (mailing address)			
	Clay	15	30
	Sand & gravel	30	70
WELL LOCATION:			
sec. 34 T 1 N R 5 E			
2 miles W of Magnolia (distance) (direction) (nearest town)			
WELL PURPOSE: Home (home, irrigation, municipal, industrial)			
WELL COMPLETION DATA:			
(1) diameter (inches) 2"			
(2) total depth (feet) 70'			
(3) static water level (feet) 47' below top of ground			
(4) casing Plastic 65' (material) (depth)			
2" if telescope see back (size)			
(5) screen 5' 65' (length) (depth to top)			
2" Plastic (size) (material)			
(6) pump 1/2 HP 3 (HP) (yield gpm)			
Just (type power)			
(7) electric log just (yes or no)			
(organization running log)			
(8) how well bottom plugged just (organization)			
DRILLERS REMARKS:			


CODED

AUG 20 1970

MISS. BD. OF
WATER COMM.

If well telescopes please sketch and show depths.

GROUND LEVEL

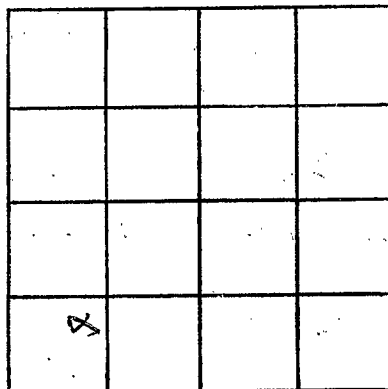

SECTION 34

Please indicate well location X.

ADDITIONAL INFORMATION

If more than one screen,
show locations of each on sketch.