

SIMPSON
K24
6-24-74

MISSISSIPPI
BOARD OF WATER COMMISSIONERS
416 North State Street
Jackson, Mississippi 39201

'CODE'

WATER WELL DRILLERS LOG

6-24-1974 ~~L.H. White~~ W. Kober Simpson
date well completed firm name county well located

LANDOWNER: L.H. White
at 1
McGehee
(mailing address)

description of formations encountered	from	to
<u>Red Clay</u>	<u>0</u>	<u>8</u>
<u>Yellow Clay</u>	<u>8</u>	<u>15</u>
<u>Blue Clay</u>	<u>15</u>	<u>32</u>
<u>Course Blue Sand</u>	<u>32</u>	<u>52</u>

WELL LOCATION:
sec. 20 T. 1 S. R. 7E SE
6 miles W of McGehee
(distance) (direction) (nearest town)

WELL PURPOSE: Home use
(home, irrigation, municipal, industrial)

- WELL COMPLETION DATA:
- (1) diameter (inches) 2
 - (2) total depth (feet) 52
 - (3) static water level (feet) 20 below above top of ground.
 - (4) casing Galv. 67
(material) (depth)
2 1/2 if telescope see back.
(size)
 - (5) screen 4 (length) (depth to top)
0 8 80 50
(size) (material)
 - (6) pump 1/2 8
(HP) (yield gpm)
Elec
(type power)
 - (7) electric log (yes or no)
Wash Valve
(organization running log)
 - (8) how well bottom plugged _____

CODED


RECEIVED
JUL 15 1974

DRILLERS REMARKS:

MISSISSIPPI BOARD OF WATER COMMISSIONERS

If well telescopes please sketch and show depths.

GROUND LEVEL

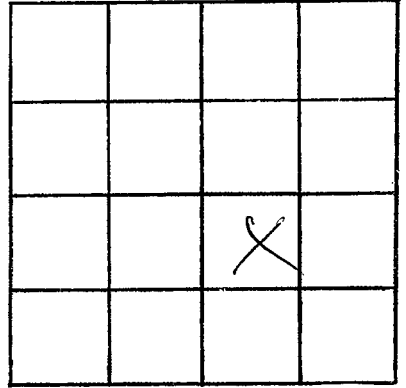

SECTION 20

Please indicate well location X.

ADDITIONAL INFORMATION

If more than one screen,
show locations of each on sketch.