

SIMPSON  
K26  
5-7-78  
Elog #197

MISSISSIPPI  
BOARD OF WATER COMMISSIONERS  
416 North State Street  
Jackson, Mississippi 39201

CODED

WATER WELL DRILLERS LOG

TOM GRIFFITH

SIMPSON

5/7/78 date well completed

PLUMBING & WELL SERVICE, INC. county well located  
320 MAYSON AVE.  
COLUMBIA, MS 39428

LANDOWNER:  
Simpson County Country Club  
Meridenhall Ms.  
(mailing address)

WELL LOCATION:  
sec. 21 T. 1 N. R. 5 E  
2 miles W of Samburg  
(distance) (direction) (nearest town)

WELL PURPOSE: Residential  
(home, irrigation, municipal, industrial)

WELL COMPLETION DATA:

- (1) diameter (inches) 6"
- (2) total depth (feet) 400 ft
- (3) static water level (feet) 32 below top of ground
- (4) casing Steel, 200ft (material) (depth)
- (5) screen 30ft, 270ft (length) (depth to top)  
6" (size) (material)
- (6) pump 15 (HP) 1409 gpm (yield gpm)  
Elec (type power)
- (7) electric log Yes (yes or no)  
Mrs Geo. Sweeney (organization running log)
- (8) how well bottom plugged B.W. Yalko

Description of formations encountered	from	to
Clay Top Soil	0	1
SAND & Gravel	1	21
SAND	21	132
SAND & Clay	132	140
SAND	140	164
Clay	164	170
SAND	170	202
Clay & Chalk	202	312
SAND	312	352
Chalk	352	372
SAND	372	400

CODED

RECEIVED  
MAY 10 1978


MISS. BD. OF WATER COMM

DRILLERS REMARKS:

(A)

If well telescopes please sketch and show depths.

GROUND LEVEL

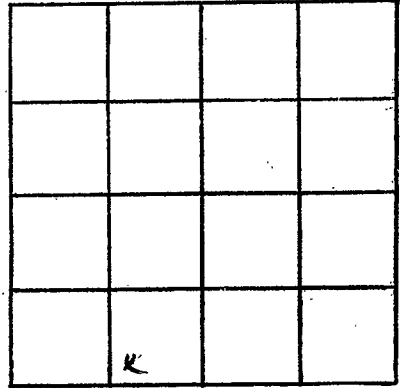

SECTION 21

Please indicate well location X.

ADDITIONAL INFORMATION

If more than one screen,  
show locations of each on sketch.