

Simpson  
K-28

MISSISSIPPI  
BOARD OF WATER COMMISSIONERS  
416 North State Street  
Jackson, Mississippi 39201

CODED

1-4-80

WATER WELL DRILLERS LOG

1-4-80 Griner Drilling Simpson

date well completed

firm name

county well located

LANDOWNER:

Amax Petroleum Corp.  
P.O. Box 42806  
Houston, Texas 77042  
(mailing address)

description of formations  
encountered

from to

chalk

0 210

chalk, sand

210 315

chalk sand

315 470

WELL LOCATION: 750' N + 1319' E of

sec. 5 T. 1 N. R. 5 E. SW/4

miles of  
(distance) (direction) (nearest town)

WELL PURPOSE: oil field supply  
(home, irrigation, municipal, industrial)

WELL COMPLETION DATA:

- (1) diameter (inches) 3"
- (2) total depth (feet) 470'
- (3) static water level (feet) 110' <sup>below</sup> ~~above~~ top of ground.
- (4) casing steel 470'  
(material) (depth)  
3"  
(size) if telescope see back.
- (5) screen 42' 428'  
(length) (depth to top)  
3" perforated  
(size) (material)
- (6) pump — 70  
(HP) (yield gpm)  
AC  
(type power)
- (7) electric log —  
(yes or no)  
—  
(organization running log)

(8) how well bottom plugged orange peel

DRILLERS REMARKS:


DEPT. OF NATURAL RESOURCES  
BUREAU OF LAND & WATER RESOURCES

JAN 24 1980

RECEIVED

If well telescopes please sketch and show depths.

GROUND LEVEL

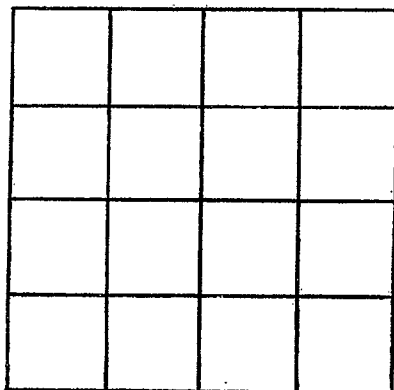

SECTION \_\_\_\_\_

Please indicate well location X.

ADDITIONAL INFORMATION

If more than one screen,  
show locations of each on sketch.