

MISSISSIPPI DEPARTMENT OF NATURAL RESOURCES

Bureau of Land and Water Resources

Southport Mall

P.O. Box 10631

Jackson, Mississippi 39209

WATER WELL DRILLERS LOG

SIMPSON
K29
5-31-82
Elog #272

DEAD

5/21 1982 RIVER DRG. SER. SIMPSON
date well completed firm name county well located

LANDOWNER: SMITH'S
CROSSING WATER ASSOC
Test well No. 1
(mailing address)

description of formations encountered	from	to
Top Soil	0	2
SAND & GRAVEL	2	132
CLAY	132	210
SAND	210	236
CLAY & ROCKS	236	310

WELL LOCATION: NW 1/4 SW 1/4 NW 1/4
sec. 11 T 1 N R 5 E

miles of (distance) (direction) of (nearest town)

DEAD

WELL PURPOSE: RURAL WATER SUPPLY
(home, irrigation, municipal, industrial)

WELL COMPLETION DATA:

- (1) diameter (inches) 5 1/2
- (2) total depth (feet) 236 ft
- (3) static water level (feet) 110 below top of ground
- (4) casing: steel 2 1/2 (material) (depth)
- (5) screen: 20 (length) 236 (depth to top)
- (size) 4 (material) 5.5
- (6) pump: 5 (HP) 60 (yield gpm)
- (type power) ELEC
- (7) electric log: Yes (yes or no)
- (organization running log) MGS

TEST
ABANDONED

(8) how well bottom plugged: BACK WASH VALVE

DRILLERS REMARKS:


DEPT. OF NATURAL RESOURCES
BUREAU OF LAND & WATER RESOURCES

AUG - 2 1982

RECEIVED

If well telescopes please sketch and show depths.

GROUND LEVEL

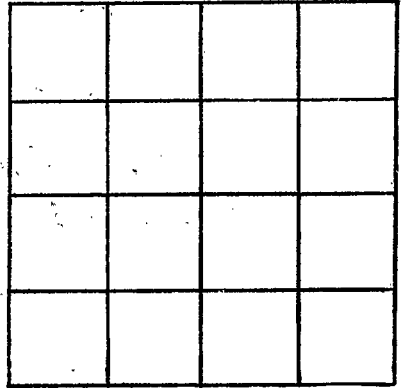

SECTION _____

Please indicate well location X.

ADDITIONAL INFORMATION

If more than one screen,
show locations of each on sketch.