

MISSISSIPPI DEPARTMENT OF NATURAL RESOURCES

Bureau of Land and Water Resources

Southport Mall

P.O. Box 10631

Jackson, Mississippi 39209

WATER WELL DRILLERS LOG

CODED

SIMPSON
K 30
7-8-82
Elog # 287

19 82 GRINER DRILLING SER. SIMPSON
date well completed firm name county well located

LANDOWNER: SMITH CROSSING
WATER ASSOC. TEST
HOLE NO. 2
(mailing address)

description of formations encountered	depth	
	from	to
<u>TOP SOIL</u>	<u>0</u>	<u>3</u>
<u>SAND & PEA GRAVEL</u>	<u>3</u>	<u>124</u>
<u>CLAY</u>	<u>124</u>	<u>200</u>
<u>SAND</u>	<u>200</u>	<u>226</u>
<u>CLAY</u>	<u>226</u>	<u>273</u>

WELL LOCATION: NE 1/4 SW 1/4
sec. 11 T 1 N 5 R 5 E W
miles of (distance) (direction) (nearest town)

WELL PURPOSE: TEST HOLE
(home, irrigation, municipal, industrial)

CODED

WELL COMPLETION DATA:

(1) diameter (inches) _____

(2) total depth (feet) _____

(3) static water level (feet) _____ below above top of ground.

(4) casing _____ (material) _____ (depth) _____
_____ (size) if telescope see back.

(5) screen _____ (length) _____ (depth to top) _____
_____ (size) _____ (material)

(6) pump _____ (HP) _____ (yield gpm) _____
_____ (type power)

(7) electric log _____ (yes or no) _____
_____ (organization running log)

(8) how well bottom plugged _____

TEST HOLE
ABANDONED

DEPT. OF NATURAL RESOURCES
BUREAU OF LAND & WATER RESOURCES


AUG - 2 1982

RECEIVED

DRILLERS REMARKS: _____

If well telescopes please sketch and show depths.

GROUND LEVEL

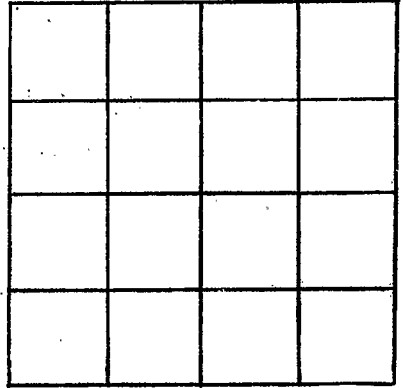

SECTION _____

Please indicate well location X.

ADDITIONAL INFORMATION

If more than one screen,
show locations of each on sketch.