

WELL # 7

MISSISSIPPI DEPARTMENT OF NATURAL RESOURCES

Bureau of Land and Water Resources

Southport Mall

P.O. Box 10631

Jackson, Mississippi 39209

WATER WELL DRILLERS LOG

Simpson
K 37
13114
GW-13114

CODED

February 15, 19 90 Layne-Central Company Simpson
date well completed firm name county well located


LANDOWNER: <u>City of Magee</u>	description of formations encountered	from	to
<u>123 North Main</u>			
<u>Magee, Ms. 39111</u> <u>(mailing address)</u>	<u>Red Sandy Clay</u>	<u>2</u>	<u>12</u>
WELL LOCATION:	<u>White Sandy Clay</u>	<u>12</u>	<u>25</u>
<u>sec. 35 T 1 N R 5 E</u> <u>S W</u>	<u>Coarse Sand & Gravel</u>	<u>25</u>	<u>99</u>
<u>SEE REVERSE SIDE</u>	<u>& Clay Streaks</u>		
<u>(distance) miles (direction) of (nearest town)</u>	<u>Sand & Gravel</u>	<u>99</u>	<u>125</u>
WELL PURPOSE: <u>Municipality</u> <u>(home, irrigation, municipal, industrial)</u>	<u>Sand & Gravel & Clay</u>	<u>125</u>	<u>145</u>
WELL COMPLETION DATA:	<u>Clay</u>	<u>145</u>	<u>153</u>
(1) diameter (inches) <u>18"</u>			
(2) total depth (feet) <u>125'</u>			
(3) static water level (feet) <u>54'</u> below above top of ground.			
(4) casing <u>Steel</u> , <u>65'</u> , (material) (depth) <u>18"</u> if telescope see back. (size)			
(5) screen <u>50'</u> , <u>125'</u> (length) (depth to top) <u>12"</u> , <u>Stainless Steel</u> (size) (material)			
(6) pump <u>25</u> , <u>533</u> (HP) (yield gpm) <u>ELECTRIC</u> (type power)			
(7) electric log <u>YES</u> (yes or no) <u>LAYNE CENTRAL CO.</u> (organization running log)			
(8) how well bottom plugged <u>12"</u> <u>Stainless Steel Plate</u>			
DRILLERS REMARKS:			

DISCOVERED
OCT 25 1990

Department of Natural Resources
Bureau of Land & Water Resources

If well telescopes please sketch and show depths.

GROUND LEVEL

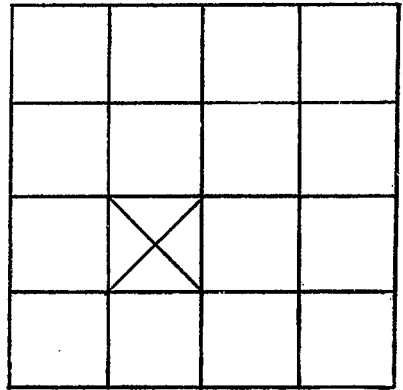

SECTION 35

Please indicate well location X.

ADDITIONAL INFORMATION

140 FEET WEST OF AT&T
R.O.W.

If more than one screen,
show locations of each on sketch.