

MISSISSIPPI DEPARTMENT OF NATURAL RESOURCES

Bureau of Land and Water Resources

Southport Mall

P.O. Box 10631

Jackson, Mississippi 39209

WATER WELL DRILLERS LOG

Simpson
K 38
13113
GW-13113

CODED


February 10, 1990 Layne-Central Company Simpson
 date well completed firm name county well located.

LANDOWNER: <u>City of Magee</u>	description of formations encountered	from	to
<u>123 North Main</u>	<u>Top Soil</u>	<u>0</u>	<u>1</u>
<u>Magee, Ms. 39111</u>	<u>Red Sandy Clay</u>	<u>1</u>	<u>13</u>
<u>(mailing address)</u>	<u>White Sandy Clay &</u>	<u>13</u>	<u>70</u>
<u>WELL LOCATION:</u>	<u>Gravel</u>		
<u>sec. <u>35</u> T <u>1 N</u> R <u>5 E</u></u>	<u>Sandy & Gravel</u>	<u>70</u>	<u>140</u>
<u>SEE REVERSE SIDE</u>	<u>Hard Clay</u>	<u>140</u>	<u>150</u>
<u>(distance) miles (direction) of (nearest town)</u>	<u>Sandy Clay</u>	<u>150</u>	<u>160</u>
<u>WELL PURPOSE: Municipality</u>			
<u>(home, irrigation, municipal, industrial)</u>			
<u>WELL COMPLETION DATA:</u>			
(1) diameter (inches) <u>18"</u>			
(2) total depth (feet) <u>130'</u>			
(3) static water level (feet) <u>50'</u> below above top of ground.			
(4) casing <u>Steel</u> , <u>75'</u>			
<u>(material)</u> , <u>(depth)</u>			
<u>18"</u> If telescope see back.			
<u>(size)</u>			
(5) screen <u>50'</u> , <u>75'</u>			
<u>(length)</u> , <u>(depth to top)</u>			
<u>12"</u> , <u>Stainless Steel</u>			
<u>(size)</u> , <u>(material)</u>			
(6) pump <u>25</u> , <u>535</u>			
<u>(HP)</u> , <u>(yield gpm)</u>			
<u>ELECTRIC</u>			
<u>(type power)</u>			
(7) electric log <u>YES</u>			
<u>(yes or no)</u>			
<u>LAYNE CENTRAL CO.</u>			
<u>(organization running log)</u>			
(8) how well bottom plugged <u>12"</u>			
<u>Stainless Steel Plate</u>			
DRILLERS REMARKS:			

RECEIVED
 OCT 25 1990
 Department of Natural Resources

If well telescopes please sketch and show depths.

GROUND LEVEL

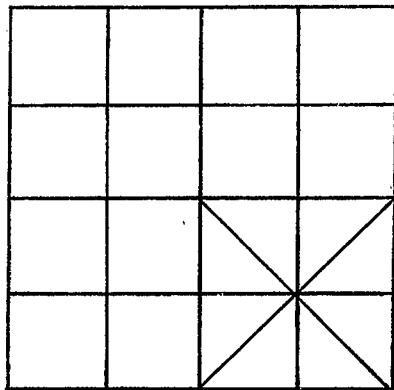

SECTION 35

Please indicate well location X. SE 1/4

ADDITIONAL INFORMATION

1900 FEET EAST OF WELL
NO. 7 AND 90 FEET SOUTH
OF GOODWATER RD.

If more than one screen,
show locations of each on sketch.