

Simpson
K 2000
8/30/76

MISSISSIPPI
BOARD OF WATER COMMISSIONERS
416 North State Street
Jackson, Mississippi 39201

WATER WELL DRILLERS LOG

8-30 1976 Will Barnes Water Well Simpson
date well completed firm name county well located

LANDOWNER: Cleo Davidson
ht. 1
menhull ms.
(mailing address)

description of formations encountered	from	to
<u>red clay</u>	<u>0</u>	<u>8</u>
<u>gravel and clay large</u>	<u>8</u>	<u>54</u>

WELL LOCATION:
sec. 2 T. 1 N. R. 10 E.
3 miles E of Weatherly
(distance) (direction) (nearest town)

(used 10 sacks sand)

WELL PURPOSE: Home
(home, irrigation, municipal, industrial)

WELL COMPLETION DATA:

(1) diameter (inches) 2

(2) total depth (feet) 54

(3) static water level (feet) 32 below above top of ground.

(4) casing Plastic, (material) (depth) 2" (size) if telescope see back.

(5) screen 5 (length) (depth to top) 08 (size) Stoulers 5" (material)

(6) pump 1/2 (HP) 0 (yield gpm)
Elec (type power)

(7) electric log no (yes or no)
(organization running log)

(8) how well bottom plugged Wash Water


RECEIVED
SEP 7 1976

DRILLERS REMARKS:

MISS. BD. OF WATER COMMISSIONERS

If well telescopes please sketch and show depths.

GROUND LEVEL

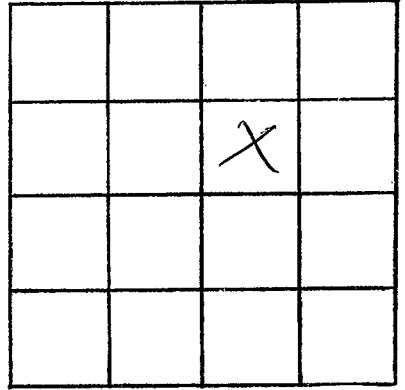

SECTION 2

Please indicate well location X.

ADDITIONAL INFORMATION

If more than one screen,
show locations of each on sketch.