

SIMPSON  
L T L-9  
2-68

MISSISSIPPI  
BOARD OF WATER COMMISSIONERS  
416 North State Street  
Jackson, Mississippi 39201

USES & SCHLUMBERGER WATER WELL DRILLERS LOG CODED  
 Feb 1968 FRIVER Drilling Service, Inc. Simpson  
 date well completed firm name county well located


LANDOWNER: OKatoma Water Ass'n.  
 (mailing address)

WELL LOCATION:  
 sec. 35 T. 1 N R. 6 E  
 4 miles E of Magee  
 (distance) (direction) (nearest town)

WELL PURPOSE: Community  
 (home, irrigation, municipal, industrial)

WELL COMPLETION DATA:  
 (2) diameter (inches) 10"  
 (2) total depth (feet) 1620'  
 (3) static water level (feet) 330' below top of ground.  
 (4) casing Steel 1540'  
 (material) (depth)  
 10 3/4" if telescope see back.  
 (size)  
 (5) screen 80' 1540'  
 (length) (depth to top)  
 6" Stainless steel  
 (size) (material)  
 (6) pump 75 300  
 (HP) (yield gpm)  
 Electric  
 (type power)  
 (7) electric log Yes  
 (yes or no)  
 USES & Schlumberger  
 (organization running log)  
 (8) how well bottom plugged Back  
 Wash Valve

description of formations encountered	from	to
Top Soil	0	10
CLAY	10	34
Course Sand & Gravel	34	207
CLAY	207	222
Sand w/ CLAY Breaks	222	292
CLAY	292	354
Sand w/ CLAY Breaks	354	407
CLAY	407	644
SAND	644	680
CLAY	680	730
SAND	730	754
CLAY	754	1090
Fine Sand w/ CLAY Breaks & Solid Rocks	1090	1344
CLAY	1344	1444
Fine Sand w/ CLAY Breaks & Solid Rocks	1444	1530
Fine SAND	1530	1800

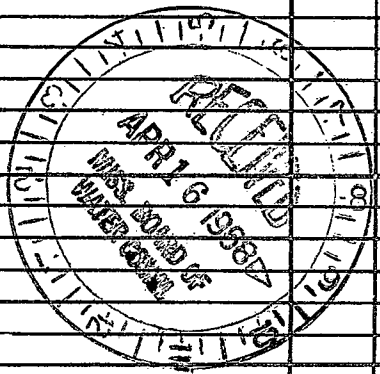

DRILLERS REMARKS: Poor Aquifer

