

SIMPSON  
L3  
6-67

MISSISSIPPI  
BOARD OF WATER COMMISSIONERS  
416 North State Street  
Jackson, Mississippi 39201

CODED

WATER WELL DRILLERS LOG

June 18, 1967 W.H. Dallas Well Repair Simpson  
date well completed firm name county well located

LANDOWNER:  
Lloyd Parker  
(mailing address)

description of formations encountered	from	to
	Clay	0
Sand	30	90
Water Sand	90	115

WELL LOCATION:  
sec. 9 T. 1 N. R. 6 E.  
Cohay  
miles (distance) of (direction) (nearest town)

WELL PURPOSE:  
(home, irrigation, municipal, industrial)

WELL COMPLETION DATA:

(1) diameter (inches) 2 in

(2) total depth (feet) 115

(3) static water level (feet) 85 below top of ground.

(4) casing NONE (material) (depth)

(size) if telescope see back.

(5) screen 6 (length) 30 (depth to top)

1 1/4 (size) bagged Brum (material)

(6) pump 3/4 (HP) (yield gpm)

(type power)

(7) electric log (yes or no)

(organization running log)

(8) how well bottom plugged


CODED

JUNE 18 1967  
MISS. BOARD OF  
WATER COMM.

DRILLERS REMARKS:

If well telescopes please sketch and show depths.

GROUND LEVEL

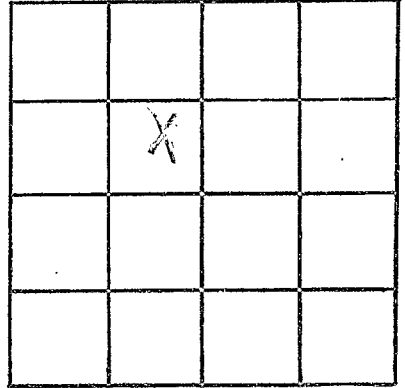

SECTION \_\_\_\_\_

Please indicate well location X.

ADDITIONAL INFORMATION

If more than one screen,  
show locations of each on sketch.