

SIMPSON
L4
8-66

MISSISSIPPI
BOARD OF WATER COMMISSIONERS
416 North State Street
Jackson, Mississippi 39201

WATER WELL DRILLERS LOG

CODED

Aug 22-66 19 W.H. Dallas's Repair Serv. Simpson
date well completed firm name county well located

LANDOWNER:
Maurin Sullivan
Rt. 1 Magee
(mailing address)

description of fomations encountered	from	to
Clay water sand	0 14	14 27
		41

WELL LOCATION:
sec 31 T 1 N R 10 E
miles City of Magee
(distance) (direction) (nearest town)

WELL PURPOSE:
(home, irrigation, municipal, industrial)

WELL COMPLETION DATA:

(1) diameter (inches) 2 in

(2) total depth (feet) 41

(3) static water level (feet) 14 ^{below} ~~above~~ top of ground.

(4) casing None, 27 ft
(material) (depth)

_____ if telescope see back.
(size)

(5) screen 6 ft, 27
(length) (depth to top)

1/4, copper brass
(size) (material)

(6) pump 1/2
(HP) (yield gpm)

_____ (type power)

(7) electric log No
(yes or no)

_____ (organization running log)

(8) how well bottom plugged _____


CODED

MISSISSIPPI BOARD OF WATER COMMISSIONERS

DRILLERS REMARKS:

If well telescopes please sketch and show depths.

GROUND LEVEL

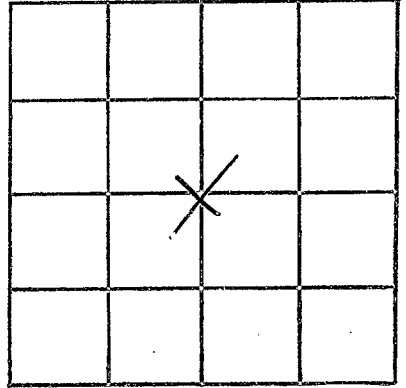

SECTION _____

Please indicate well location X.

ADDITIONAL INFORMATION

If more than one screen,
show locations of each on sketch.