

SIMPSON
 L 5
 5-68

MISSISSIPPI
 BOARD OF WATER COMMISSIONERS
 416 North State Street
 Jackson, Mississippi 39201

CODED

WATER WELL DRILLERS LOG

May 27 1968 W. H. Dallas well located Simpson
 date well completed firm name county well located

LANDOWNER:
 Barbara
 (mailing address)

description of formations encountered	from	to
Clay	0	21
red sand	21	60
Water sand	60	82

WELL LOCATION:
 sec 26 T 1 N R 12 E
 S W
 miles 1 1/2 of Magee
 (distance) (direction) (nearest town)

WELL PURPOSE:
 (home, irrigation, municipal, industrial)

WELL COMPLETION DATA:
 (1) diameter (inches) 2 in
 (2) total depth (feet) 82
 (3) static water level (feet) 100 ft Below top of ground.
 (4) casing 10 ft 4 in Plastic 32 (material) (depth)
 (size) if telescope see back.
 (5) screen 5 ft (length) (depth to top)
 1 1/4" 8 slot Brass (size) (material)
 (6) pump 3/4 (HP) (yield gpm)
 (type power)
 (7) electric log No (yes or no)
 (organization running log)
 (8) how well bottom plugged


CODED

MISSISSIPPI
 BOARD OF
 WATER COMMISSIONERS

DRILLERS REMARKS:

If well telescopes please sketch and show depths.

GROUND LEVEL

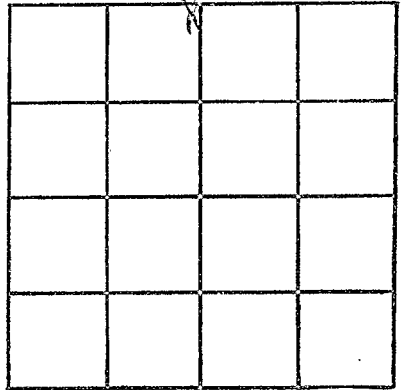

SECTION _____

Please indicate well location X.

ADDITIONAL INFORMATION

If more than one screen,
show locations of each on sketch.