

L 6
8-16-60

WATER WELL DRILLERS LOG

L-300
Simpson
~~Smith~~

Date: 8/16, 1960, Driller: James A. White County Simpson
(Name) **CODED**

(1) Owner of Land:	Description & Color of Materials Sand, Clay, Red Clay, Shell, etc.	Thick- ness Feet	Depth Feet
<u>Charley Hughes</u> (Name) <u>Rt one magu, miss</u> (Address)	<u>red clay</u>	<u>15</u>	<u>15</u>
(2) Location: <u>NE 1/4, NE 1/4, Sec 22 T. 1 R. 6 E</u> <u>5</u> miles <u>NE</u> of <u>magu</u> (distance) (direction) (Nearest Town)	<u>sand</u>	<u>53</u>	<u>70</u>
(3) Topography: <input checked="" type="checkbox"/> (Hilly) <input type="checkbox"/> (Flat) <input type="checkbox"/> (Level)			
(4) Purpose of Well: <u>Domestic</u> (Domestic Irrigation Municipal, Industrial, Other)			


Information upon completion of well:

- (1) Diameter 2 inches.
- (2) Total Depth 70 feet.
- (3) Water Level 56 feet below top of ground.
- (4) Cased to 59, Size #2.
- (5) Screen: Size 1 1/4", Length 10 ft.
- (6) Were any formations sealed against pollution?
_____ yes, _____ no.

If YES depth of formation _____

Why _____

Drillers Remarks: _____

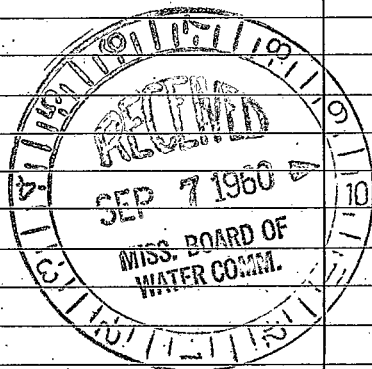

(Use Back Side)

Well No.

.....

.....

