

SIMPSON
 L11
 9-20-70

MISSISSIPPI
 BOARD OF WATER COMMISSIONERS
 416 North State Street
 Jackson, Mississippi 39201

CODED

WATER WELL DRILLERS LOG

9 20 1970 McWilliams, W.W.S. SIMPSON
 date well completed firm name county well located

LANDOWNER: W.H. Everett
Rt-1 Box 355
Magee Miss. 39111
 (mailing address)

description of formations encountered	from	to
CLAY	0	12
SAND	12	25
CHALK	25	63
GRAVEL	63	70
SAND	70	90
MIT. WATER SANDS	90	101

WELL LOCATION:
 sec. 29 T 10 N R 6 E
4 miles NE of MAGEE
 (distance) (direction) (nearest town)

WELL PURPOSE: home, farm
 (home, irrigation, municipal, industrial)

WELL COMPLETION DATA:

(1) diameter (inches) 2"

(2) total depth (feet) 111

(3) static water level (feet) 70 below above top of ground.

(4) casing Galv (material) (depth) (size) if telescope see back.

(5) screen 571 (length) (depth to top) 60# BRONZE (size) (material)

(6) pump 1 360 (HP) (yield gpm) (type power)

(7) electric log NO (yes or no) (organization running log)

(8) how well bottom plugged 1/4 PLUG

CODED


PER 27 1971

MISS. Bd. of WATER COMMISSIONERS

DRILLERS REMARKS:

If well telescopes please sketch and show depths.

GROUND LEVEL

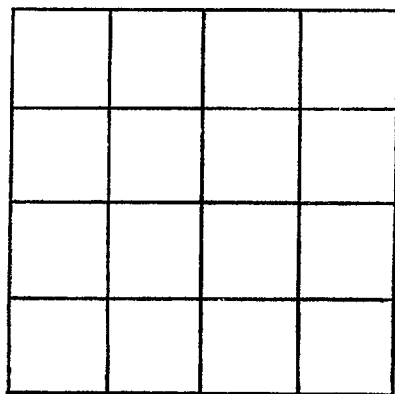

SECTION _____

Please indicate well location X.

ADDITIONAL INFORMATION

If more than one screen,
show locations of each on sketch.