

SIMPSON  
L 12  
3-71

MISSISSIPPI  
BOARD OF WATER COMMISSIONERS  
416 North State Street  
Jackson, Mississippi 39201

**CODED**

WATER WELL DRILLERS LOG

March, 1971 W. E. Thompson Simpson  
date well completed firm name county well located

LANDOWNER:	description of formations encountered	from	to
<u>Jerry Horvath</u>	<u>top soil</u>	<u>0</u>	<u>5</u>
<u>Maguer</u> (mailing address)	<u>sand &amp; gravel</u>	<u>5</u>	<u>45</u>
WELL LOCATION: sec <u>20</u> T <u>1</u> N R <u>6</u> E <u>2</u> miles <u>NE</u> of <u>Maguer</u> (distance) (direction) (nearest town)	<u>White clay</u>	<u>45</u>	<u>120</u>
WELL PURPOSE: (home, irrigation, municipal, industrial)	<u>clay</u>	<u>120</u>	<u>143</u>
WELL COMPLETION DATA:	<u>Clay Below</u>	<u>143</u>	<u>147</u>
(1) diameter (inches) <u>2"</u>			
(2) total depth (feet) <u>147'</u>			
(3) static water level (feet) <u>85</u> below top of ground.			
(4) casing <u>Plastic 135'</u> (material) (depth) <u>2"</u> if telescope see back. (size)			
(5) screen <u>5'</u> <u>135'</u> (length) (depth to top) <u>2"</u> (size) <u>Plastic</u> (material)			
(6) pump <u>1</u> (HP) <u>6</u> (yield gpm) <u>Foot</u> (type power)			
(7) electric log <u>no</u> (yes or no) (organization running log)			
(8) how well bottom plugged <u>By hand</u>			
DRILLERS REMARKS:			


**CODED**

MAY 12 1971

MISS. Bd. of  
WATER ADMIN.

If well telescopes please sketch and show depths.

GROUND LEVEL

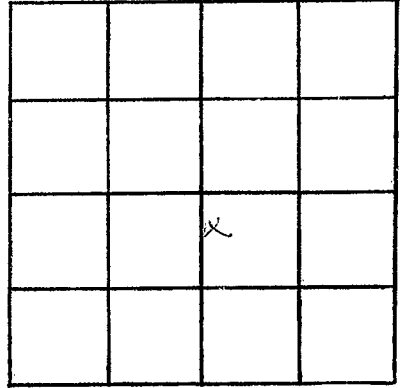

SECTION 20

Please indicate well location X.

ADDITIONAL INFORMATION

If more than one screen, show locations of each on sketch.