

MISSISSIPPI DEPARTMENT OF NATURAL RESOURCES

Bureau of Land and Water Resources

Southport Mall

P.O. Box 10631

Jackson, Mississippi 39209

WATER WELL DRILLERS LOG

CODED

SIMPSON  
L 14  
4/13/83  
E log #295

APR - MAY 1983 BRIVER DRILLING SER. SIMPSON  
date well completed firm name county well located

LANDOWNER: OKATAMA  
WATER ASSOC., WELL  
No. (mailing address)

WELL LOCATION: NE 1/4 NW 1/4  
sec. 35 T. 1 (N) R. 6 (E)  
S. miles of (distance) (direction) (nearest town)

WELL PURPOSE: RURAL WATER  
(home, irrigation, municipal, industrial)

- WELL COMPLETION DATA:
- (1) diameter (inches) 18 x 12"
  - (2) total depth (feet) 212 ft.
  - (3) static water level (feet) 100 ft. below top of ground.
  - (4) casing Steel 165 ft.  
(material) (depth)  
18" If telescope see back.  
(size)
  - (5) screen 42 ft. 170 ft.  
(length) (depth to top)  
12" (1030) 304 S.S.  
(size) (material)
  - (6) pump 40 500  
(HP) (yield gpm)  
ELECT. 12" PVC CAP  
(type power) TO SURFACE
  - (7) electric log YES  
(yes or no)  
MISS. GEOL. SURVEY  
(organization running log)
  - (8) how well bottom plugged YES  
5" x 3" PLATE

description of formations encountered	from	to
TOP SOIL	0	2
ROCK + GRAVEL	2	21
PER GRAVEL	21	42
PER GRAVEL + SAND	42	147
SAND + CLAY	147	168
PER GRAVEL + SAND	168	210
SAND + CLAY	210	231
CLAY + SAND	231	252
SAND + CLAY	252	273
STREMS OF SAND + CLAY	273	315
SAND + CLAY	315	336
CLAY, HARD + ROCK (STOPPED ON ROCK)	336	360

CODED

NO  
18 x 12"

DEPT. OF NATURAL RESOURCES  
BUREAU OF LAND & WATER RESOURCES

MAY 2 - 1983


RECEIVED

DRILLERS REMARKS:



If well telescopes please sketch and show depths.

GROUND LEVEL

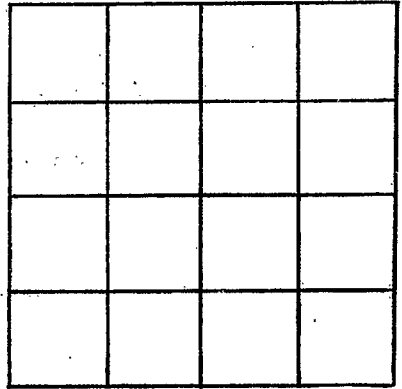

SECTION \_\_\_\_\_

Please indicate well location X.

ADDITIONAL INFORMATION

If more than one screen,  
show locations of each on sketch.