

MISSISSIPPI DEPARTMENT OF NATURAL RESOURCES

Bureau of Land and Water Resources

Southport Mall

P.O. Box 10631

Jackson, Mississippi 39209

CODED

WATER WELL DRILLERS LOG

TOM GRIFFITH

DRILLING & WELL SERVICE, INC.

320 MAYSON AVE.

Simpson

county well located

SIMPSON
L 15
4/18/83

4-18 1983
date well completed

LANDOWNER: Wiley Ainsworth
Rt. 1
Magee, MS
(mailing address)

description of formations encountered	from	to
Topsoil	0'	1'
Chalk	1'	25'
Sand & Peagravel	25'	140'

WELL LOCATION:
sec. 9 T. 10 N. R. 6 E.
4 miles NW of Magee
(distance) (direction) (nearest town)

WELL PURPOSE: Home
(home, irrigation, municipal, industrial)

WELL COMPLETION DATA:

(1) diameter (inches) 4"

(2) total depth (feet) 120'

(3) static water level (feet) 45' below above top of ground.

(4) casing PVC, 120'
(material) (depth)

N/A if telescope see back.
(size)

(5) screen 20', 140'
(length) (depth to top)

4", PVC
(size) (material)

(6) pump 2 35
(HP) (yield gpm)

electric
(type power)

(7) electric log No
(yes or no)

(organization running log)

(8) how well bottom plugged check
value

CODED

DEPT. OF NATURAL RESOURCES
BUREAU OF LAND & WATER RESOURCES


MAY 18 1983

RECEIVED

DRILLERS REMARKS:

If well telescopes please sketch and show depths.

GROUND LEVEL

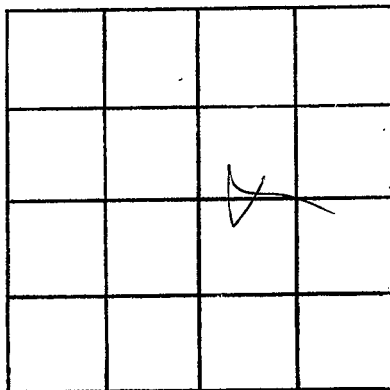

SECTION 9

Please indicate well location X.

ADDITIONAL INFORMATION

If more than one screen, show locations of each on sketch.