

SIMPSON
L 2000
8-13-80

MISSISSIPPI
 BOARD OF WATER COMMISSIONERS
 416 North State Street
 Jackson, Mississippi 39201

WATER WELL DRILLERS LOG

Aug 13 1980 Roy V. West Drlg Simpson
 date well completed firm name county well located

LANDOWNER:	description of formations encountered	from	to
<u>M^cMANUS</u>			
<u>MAGEE</u> (mailing address)	<u>SAND</u>	<u>3</u>	<u>60</u>
	<u>GRAVEL</u>	<u>60</u>	<u>70</u>
	<u>SAND</u>	<u>70</u>	<u>100</u>
WELL LOCATION:			
sec. <u>30</u> T <u>1</u> N R <u>#76</u>			
<u>1</u> miles <u>NW</u> of <u>MAGEE</u>			
(distance) (direction) (nearest town)			
WELL PURPOSE: <u>HOME</u> (home, irrigation, municipal, industrial)			
WELL COMPLETION DATA:			
(1) diameter (inches) <u>2"</u>			
(2) total depth (feet) <u>100'</u>			
(3) static water level (feet) <u>54'</u> below above top of ground.			
(4) casing <u>PVC</u> , <u>95'</u> (material) (depth)			
(size) If telescope see back.			
(5) screen <u>5'</u> , <u>95'</u> (length) (depth to top)			
<u>2"</u> , <u>PVC</u> (size) (material)			
(6) pump <u>1</u> <u>6</u> (HP) (yield gpm)			
<u>REA</u> (type power)			
(7) electric log <u>NO</u> (yes or no)			
(organization running log)			
(8) how well bottom plugged <u>WASH VALUE</u>			
DRILLERS REMARKS:			


DEPT. OF NATURAL RESOURCES
 BUREAU OF LAND & WATER RESOURCES

SEP 11 1980

RECEIVED

If well telescopes please sketch and show depths.

GROUND LEVEL

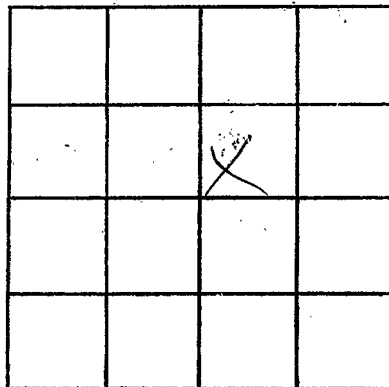

SECTION _____

Please indicate well location X.

ADDITIONAL INFORMATION

If more than one screen,
show locations of each on sketch.