

Simpson
 L 2001
 8-14-80

MISSISSIPPI
 BOARD OF WATER COMMISSIONERS
 416 North State Street
 Jackson, Mississippi 39201

WATER WELL DRILLERS LOG

Aug 14 1980 Roy V. West Drilling Simpson
 date well completed firm name county well located

LANDOWNER:	description of formations encountered	from	to
JUNIOR RANKIN MAGEE (mailing address)			
	SAND	3	60
	CAJAL SAND	60	70
	SAND	70	90
WELL LOCATION: sec. 30 T 1 N R 2 E 6 S 1 miles NB of MAGEE (distance) (direction) (nearest town)			
WELL PURPOSE: HOME (home, irrigation, municipal, industrial)			
WELL COMPLETION DATA:			
(1) diameter (inches) 2"			
(2) total depth (feet) 90'			
(3) static water level (feet) 52' below top of ground.			
(4) casing PVC 85' (material) (depth)			
(size) If telescope see back.			
(5) screen 5' 85' (length) (depth to top)			
2" PVC (size) (material)			
(6) pump 1 8 (HP) (yield gpm)			
REA (type power)			
(7) electric log NO (yes or no)			
(organization running log)			
(8) how well bottom plugged WASH VALVE			
DRILLERS REMARKS:			


DEPT. OF NATURAL RESOURCES
 BUREAU OF LAND & WATER RESOURCES

SEP 11 1980

RECEIVED

If well telescopes please sketch and show depths.

GROUND LEVEL

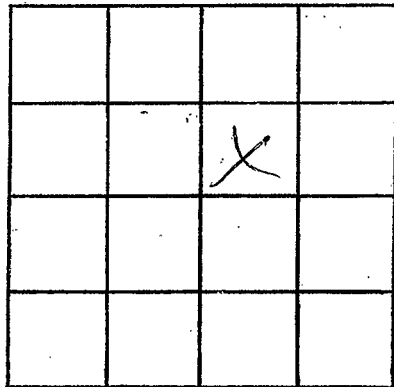

SECTION _____

Please indicate well location X.

ADDITIONAL INFORMATION

If more than one screen,
show locations of each on sketch.