

MISSISSIPPI DEPARTMENT OF ENVIRONMENTAL QUALITY
Bureau of Land and Water Resources

P. O. Box 10631
Jackson, MS 39289-0631
WATER WELL DRILLERS LOG

COUNTY WELL LOCATED	
Simpson	
WELL NUMBER	CODED
L	
2002	
DATE WELL COMPLETED	
3-20-91	

PERMIT NUMBER
NAME OF DRILLING FIRM
Roy U. West

NAME & MAILING ADDRESS OF LANDOWNER		
Jerry Warren		
P.O. Box 524		
Mager MS 39111		
WELL LOCATION:	SEC	TOWNSHIP
	34	1 N S 6 E
DISTANCE	DIRECTION	NEAREST TOWN
5 Miles	E	of Mager
OTHER LANDMARK		
WELL PURPOSE: Home, Irrigation, Municipal, Industrial, Fish Pond, etc.		
Poultry Farm		

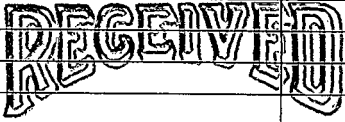
PUMP DATA		
PUMP TYPE (Circle One):		
Submersible	Turbine	Jet
Other (Describe) _____		
POWER TYPE (Circle One):		
Electric	Tractor	Diesel
Other (Describe) _____		
Pump Capacity (GPM)	No. of Stages	Setting Depth
12		140' FT.
PUMP TEST		
Well yielded _____ GPM with		
a drawdown of _____ ft.		
after _____ hours of pumping		

WELL DATA		
Well Depth	Casing Diameter (In.)	Casing Length (Ft.)
157'	4"	147'
Type of Casing	Hole Depth	Depth to Static Water Level
PVC	157'	103'
TYPE OF COMPLETION: (Circle One or More):		
Gravel Packed	Underreamed	Telescoped
Natural Development	Open Hole	Other
(Describe) _____		
Top of Lap Pipe or Reduction in Casing		
FEET	IF TELESCOPED OR MORE THAN ONE SCREEN: USE BACK PAGE	

LOG DATA	
TYPE OF LOG RUN (Circle One):	
Electric	No Log Run
Other (Describe) _____	
Name of Organization Running Log	

SCREEN DATA		
Diameter - Inches	Length - Feet	Slot Size - Inches
4	10	.010
Screen Type	Depth to Bottom - Feet	
PVC	157'	

GEOLOGIC DATA (Office Use Only)			
Surface Elev.	Geologic Unit	Unit Thickness	Depth to Top
Subs. SWL	Date	Analysis	Aquifer Test
Driller's Remarks			

DESCRIPTION OF FORMATIONS ENCOUNTERED	FROM	TO	FORMATIONS (Continued)	FROM	TO
SANDY CLAY	0	14	 MAY 2 1991 Dept. of Environmental Quality Bureau of Land & Water Resources		
SAND	14	87			
SAND & GRAVEL	87	157			

IF MORE SPACE IS NEEDED, USE BACK

If well telescopes please sketch and show depths.

GROUND LEVEL

			X

SECTION

34

Please indicate well location X.

ADDITIONAL INFORMATION

If more than one screen,
show location/of each on sketch.