

SIMPSON
M 2
6-67

MISSISSIPPI
BOARD OF WATER COMMISSIONERS
416 North State Street
Jackson, Mississippi 39201

CODED

WATER WELL DRILLERS LOG

~~June 25~~ June 25, 1967 W.H. Dallas Well Repair Superior
date well completed firm name county well located

LANDOWNER:
Bizer Baggett
(mailing address)

description of fomations encountered	from	to
Clay	0	10
Hard	10	30
Chalk	30	67
Water Sand	67	85

WELL LOCATION:
sec 2 T 9 N R 21 E
S W
_____ miles E of total
(distance) (direction) (nearest town)

WELL PURPOSE:
(home, irrigation, municipal, industrial)

WELL COMPLETION DATA:

(1) diameter (inches) 2 in

(2) total depth (feet) 85

(3) static water level (feet) 67 below above top of ground

(4) casing plastic, 20ft
(material) (depth)
_____ if telescope see back.
(size)

(5) screen 6ft, 18
(length) (depth to top)
1/4, 10 dot brass
(size) (material)

(6) pump _____
(HP) (yield gpm)
(type power)

(7) electric log No
(yes or no)
(organization running log)

(8) how well bottom plugged _____


CODED

RECORDED - 1968
MISS. BOARD OF
WATER COMM.

DRILLERS REMARKS:

If well telescopes please sketch and show depths.

GROUND LEVEL

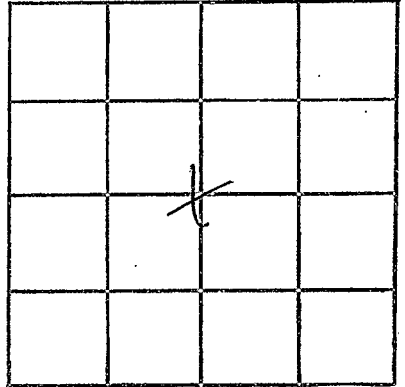

SECTION _____

Please indicate well location X.

ADDITIONAL INFORMATION

If more than one screen, show locations of each on sketch.