

Simpson

MS

5-66

E-109

MISSISSIPPI BOARD OF WATER COMMISSIONERS

416 North State Street  
Jackson, Mississippi 39201

CODED

WATER WELL DRILLERS LOG

5/12 1966 date well completed  
Water Well Dev Co. firm name  
Simpson county well located

LANDOWNER: L.R. Higginton

Pineola, Miss.

(mailing address)

description of formations encountered

from to

Red Clay + Sand

0 105

bedrock

105 190

Blue clay

190 420

Sand

420 484

WELL LOCATION: W/2 SE/4

sec. 12 T. 10 N. R. 21 E.

10 miles N.W. of Pineola  
(distance) (direction) (nearest town)

WELL PURPOSE: Home  
(home, irrigation, municipal, industrial)

WELL COMPLETION DATA:

- (1) diameter (inches) 2 x 4
- (2) total depth (feet) 484
- (3) static water level (feet) <sup>flowing</sup> below top of ground.

CODED

(4) casing C.I. 105  
(material) (depth)

4" (size) If telescope see back.

(5) screen 10' 460'  
(length) (depth to top)

2" (size) S.S. (material)

(6) pump 0 - Flowing  
(HP) (yield gpm)

Gas (type power)

(7) electric log Yes  
(yes or no)

Miss. Well Dev. Co. (organization running log)

(8) how well bottom plugged

JUL - 8 1966


MISS. BOARD OF WATER COMM.

DRILLERS REMARKS:

Flowing well

If well telescopes please sketch and show depths.

GROUND LEVEL

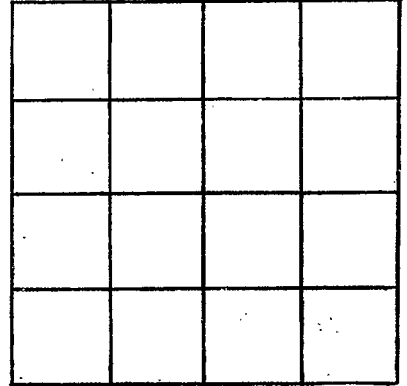

SECTION \_\_\_\_\_

Please indicate well location X.

ADDITIONAL INFORMATION

If more than one screen, show locations of each on sketch.