

Simpson

M6

5-26-70

MISSISSIPPI  
 BOARD OF WATER COMMISSIONERS  
 416 North State Street  
 Jackson, Mississippi 39201

CODED

WATER WELL DRILLERS LOG

5/26

date well completed

1970

firm name

*N. E. Thompson & Simpson*

county well located

LANDOWNER:

*Mandy Little*

*Rockport, Miss.*  
(mailing address)

description of formations encountered

from

to

*surface clay*

0

10

*blue clay*

10

40

*sand*

40

140

*blue clay*

140

180

*sand*

180

210

*blue clay*

210

610

*sand*

610

642

WELL LOCATION:

sec. *26 T 20 N* R *21 E*  
*C* miles *77* of *Rockport*  
(distance) (direction) (nearest town)

WELL PURPOSE: *home*  
(home, irrigation, municipal, industrial)

WELL COMPLETION DATA:

- (1) diameter (inches) *2"*
- (2) total depth (feet) *642'*
- (3) static water level (feet) *2'* below above top of ground.
- (4) casing *Plastic, 619"*  
(material) (depth)  
*2"*  
(size) if telescope see back.
- (5) screen *15"*, *619*  
(length) (depth to top)  
*2"*, *Plastic*  
(size) (material)
- (6) pump *1 1/2*, *34*  
(HP) (yield gpm)  
*air*  
(type power)
- (7) electric log *yes*  
(yes or no)  
*M. H. S.*  
(organization running log)

OPEN

(8) how well bottom plugged *B/W 90%*


MAY 19 1970

DRILLERS REMARKS:

MISS. BD. OF  
WATER COMM.

If well telescopes please sketch and show depths.

GROUND LEVEL

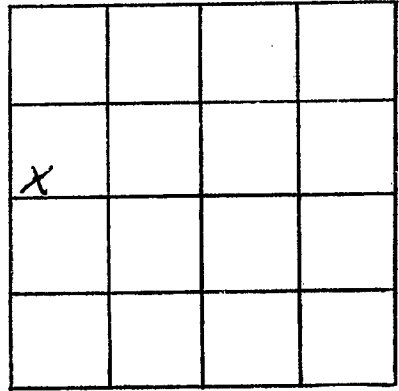

SECTION 26

Please indicate well location X.

ADDITIONAL INFORMATION

If more than one screen,  
show locations of each on sketch.