

SIMPSON

MIO

6-26-73

MISSISSIPPI BOARD OF WATER COMMISSIONERS
416 North State Street
Jackson, Mississippi 39201

CODED

WATER WELL DRILLERS LOG

June 26 1973 K. E. Thompson Simpson
date well completed firm name county well located

LANDOWNER:	description of formations encountered	from	to
<u>H. H. Bryant</u>	<u>top soil</u>	0	5
<u>Dunala miss.</u> (mailing address)	<u>hardly</u>	5	75
WELL LOCATION: sec <u>23</u> T <u>10</u> N R <u>21</u> E # W <u>7</u> miles <u>SW</u> of <u>Dunala</u> (distance) (direction) (nearest town)	<u>strong clay</u>	75	135
WELL PURPOSE: <u>Home</u> (home, irrigation, municipal, industrial)	<u>hard</u>	135	220
WELL COMPLETION DATA:			
(1) diameter (inches) <u>2"</u>			
(2) total depth (feet) <u>220'</u>			
(3) static water level (feet) <u>85'</u> below above top of ground.			
(4) casing <u>Plastic 205'</u> (material) (depth) <u>2"</u> (size) if telescope see back.			
(5) screen <u>10'</u> <u>205'</u> (length) (depth to top)			
<u>.008</u> <u>Plastic</u> (size) (material)			
(6) pump <u>1</u> <u>10</u> (HP) (yield gpm)			
<u>air well</u> (type power)			
(7) electric log <u>no</u> (yes or no)			
(organization running log)			
(8) how well bottom plugged <u>By well</u>			
DRILLERS REMARKS:			


CODED

JUN 28 1973

MISS. Bd. of
WATER COMMISSIONERS

If well telescopes please sketch and show depths.

GROUND LEVEL

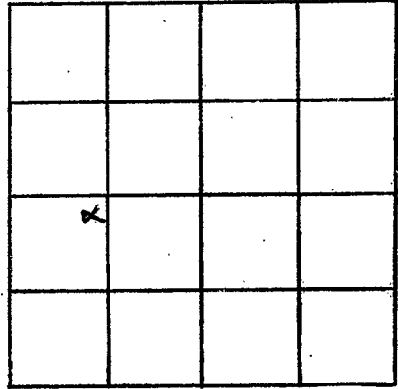

SECTION 23

Please indicate well location X.

ADDITIONAL INFORMATION

If more than one screen, show locations of each on sketch.