

IPSON
M 11
4-5-74

MISSISSIPPI
BOARD OF WATER COMMISSIONERS
416 North State Street
Jackson, Mississippi 39201

CODED

WATER WELL DRILLERS LOG

4/5/74 19 W. E. Thompson Sevier
date well completed firm name county well located

| LANDOWNER: | description of formations encountered | from | to |
|--|---------------------------------------|------|-----|
| <u>Chas Buckley</u> | <u>surface</u> | 0 | 5 |
| <u>Pine Bluff Miss</u> (mailing address) | <u>blue clay</u> | 5 | 120 |
| WELL LOCATION: sec <u>22</u> T <u>10</u> (N) R <u>21</u> (E) <u>8</u> miles <u>S/W</u> of <u>Pine Bluff</u> (distance) (direction) (nearest town) | <u>sand</u> | 120 | 180 |
| WELL PURPOSE: <u>home</u> (home, irrigation, municipal, industrial) | | | |
| WELL COMPLETION DATA: | | | |
| (1) diameter (inches) <u>2"</u> | | | |
| (2) total depth (feet) <u>180'</u> | | | |
| (3) static water level (feet) <u>50'</u> below top of ground. | | | |
| (4) casing <u>Plate 170'</u> (material) (depth) <u>2"</u> if telescope see back. (size) | | | |
| (5) screen <u>10'</u> <u>170'</u> (length) (depth to top) | | | |
| <u>1/2"</u> <u>Plate</u> (size) (material) | | | |
| (6) pump <u>1</u> <u>500 GPM</u> (HP) (yield gpm) | | | |
| <u>240</u> (type power) | | | |
| (7) electric log <u>no</u> (yes or no) | | | |
| (organization running log) | | | |
| (8) how well bottom plugged | | | |
| DRILLERS REMARKS: | | | |

CODED


DEC 11 1974

APR 9 1975

MISSISSIPPI WATER COMMISSION

If well telescopes please sketch and show depths.

GROUND LEVEL

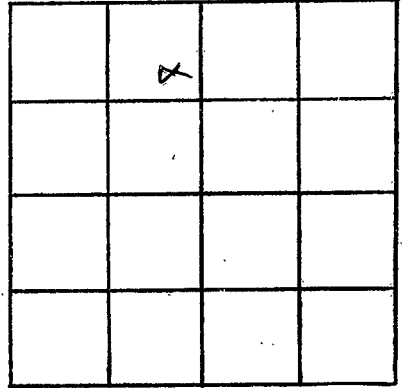

SECTION 22

Please indicate well location X.

ADDITIONAL INFORMATION

If more than one screen, show locations of each on sketch.