

CODED

SIMPSON
M12
12-1-73

MISSISSIPPI
BOARD OF WATER COMMISSIONERS
416 North State Street
Jackson, Mississippi 39201

WATER WELL DRILLERS LOG

12-1-73 date well completed 1973 GRINER - GINN firm name SIMPSON county well located

LANDOWNER:
James Wilson
Rt. 1, Box 64 Rindal, Miss.
(mailing address)

description of formations encountered	from	to
top soil	0	1
clay	1	161
a layer of gravel	161	280
chert	280	518
sand	518	580

WELL LOCATION:
sec 3 T 10 S R 21 E
3 miles S.W. of Union
(distance) (direction) (nearest town)

WELL PURPOSE: Home
(home, irrigation, municipal, industrial)

- WELL COMPLETION DATA:
- (1) diameter (inches) 2"
 - (2) total depth (feet) 580
 - (3) static water level (feet) 3 below top of ground. above
 - (4) casing plastic, 570, (material) (depth)
2" (size) If telescope see back.
 - (5) screen 10', 570 (length) (depth to top)
2" plastic (size) (material)
 - (6) pump 1/3 5 (HP) (yield gpm)
elec (type power)
 - (7) electric log NO (yes or no)
NO (organization running log)
 - (8) how well bottom plugged B.W. Valve

CODED


DEPT. OF WATER CONTROL
MAY 20 1974

DRILLERS REMARKS:

MISS. DP. OF WATER CONTROL

If well telescopes please sketch and show depths.

GROUND LEVEL

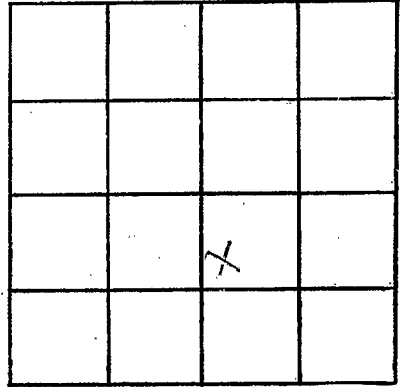

SECTION

3

Please indicate well location X.

ADDITIONAL INFORMATION

If more than one screen,
show locations of each on sketch.