

SIMPSON
M 14
10/25/74

MISSISSIPPI
BOARD OF WATER COMMISSIONERS
416 North State Street
Jackson, Mississippi 39201

WATER WELL DRILLERS LOG

CODED

10/25/74 19 R. E. Thompson Simpson
date well completed firm name county well located

LANDOWNER:
Dear Little
New N. H. H. Co.
(mailing address)

description of formations encountered	from	to
<u>Clay</u>	<u>0</u>	<u>20</u>
<u>Sand</u>	<u>20</u>	<u>69</u>
<u>Blue clay</u>	<u>69</u>	<u>140</u>
<u>Sand</u>	<u>140</u>	<u>180</u>

WELL LOCATION:
sec 27 T. 10 N. R. 21 E.
S. W.
7 miles W of Pinebluff
(distance) (direction) (nearest town)

WELL PURPOSE: Home
(home, irrigation, municipal, industrial)

WELL COMPLETION DATA:

(1) diameter (inches) 2"

(2) total depth (feet) 180'

(3) static water level (feet) 42' below above top of ground.

(4) casing Plastic, 170'
(material) (depth)
2"
(size) if telescope see back.

(5) screen 10', 170'
(length) (depth to top)
008, Plastic
(size) (material)

(6) pump Old Pump 4
(HP) (yield gpm)
Just
(type power)

(7) electric log no
(yes or no)

(organization running log)

(8) how well bottom plugged


DRILLERS REMARKS:
With out 30 M.G.M.

RECEIVED
OCT 31 1974

MISS. BD. OF WATER COMMISSIONERS

If well telescopes please sketch and show depths.

GROUND LEVEL

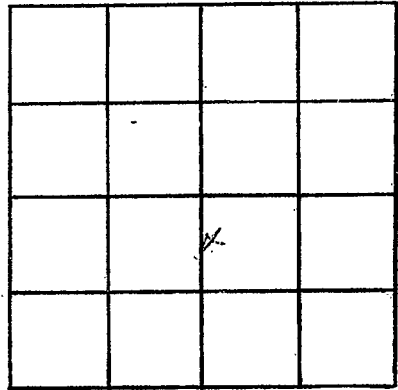

SECTION 27

Please indicate well location X.

ADDITIONAL INFORMATION

If more than one screen, show locations of each on sketch.