

SIMPSON
M15
7-16-80

MISSISSIPPI
 BOARD OF WATER COMMISSIONERS
 416 North State Street
 Jackson, Mississippi 39201

CODED ✓

WATER WELL DRILLERS LOG

7-16
 date well completed

1980 Gumwell for
 firm name

Superior
 county well located

LANDOWNER:

Jerome Brent
Jerome Brent
 (mailing address)

description of formations encountered

from to

SAND & GRAVEL	0	80
CLAY	80	275
SAND	275	285
CLAY	285	300
SAND	300	390

WELL LOCATION:

sec. 4 T. 10 N. R. 9 E. W. 1

_____ miles _____ of _____
 (distance) (direction) (nearest town)

WELL PURPOSE:

(home, irrigation, municipal, industrial)

CODED

WELL COMPLETION DATA:

- (1) diameter (inches) 2"
- (2) total depth (feet) 390
- (3) static water level (feet) 2 below/above top of ground.
- (4) casing PVC 340
 (material) (depth)
2" if telescope see back.
 (size)
- (5) screen 10 300
 (length) (depth to top)
2" PVC
 (size) (material)
- (6) pump 1 0
 (HP) (yield gpm)

 (type power)
- (7) electric log _____
 (yes, or no.)
MCS
 (organization running log)
- (8) how well bottom plugged BWV

DRILLERS REMARKS:


DEPT. OF NATURAL RESOURCES
 BUREAU OF LAND & WATER RESOURCES

NOV 12 1980

RECEIVED

If well telescopes please sketch and show depths.

GROUND LEVEL

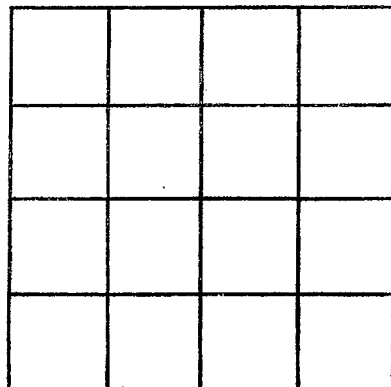

SECTION _____

Please indicate well location X.

ADDITIONAL INFORMATION

If more than one screen,
show locations of each on sketch.