

SIMPSON
M16
8-19-80

MISSISSIPPI
 BOARD OF WATER COMMISSIONERS
 416 North State Street
 Jackson, Mississippi 39201

CODED


WATER WELL DRILLERS LOG

6-19 1980 Summers Simpson
 date well completed firm name county well located

LANDOWNER:	description of formations encountered	from	to
<u>Bertha Mahaffey</u> BERTHA Mahaffey (mailing address)	<u>Sandy</u> <u>Clay & s</u> <u>Sand</u> <u>Clay & s</u> <u>Sand</u>	<u>0</u> <u>100</u> <u>100</u> <u>150</u> <u>330</u>	<u>60</u> <u>100</u> <u>150</u> <u>330</u> <u>350</u>
WELL LOCATION: sec. <u>3</u> T. <u>10</u> N. R. <u>2</u> E. W. (distance) miles (direction) of (nearest town)	<p style="text-align: center;">CODED</p>		
WELL PURPOSE: (home, irrigation, municipal, industrial.)			
WELL COMPLETION DATA: (1) diameter (inches) <u>2 1/2</u> (2) total depth (feet) <u>350</u> (3) static water level (feet) <u>140</u> below above top of ground. (4) casing <u>PVC</u> <u>330</u> (material) (depth) <u>2 1/2</u> if telescope see back. (size) (5) screen <u>25</u> <u>330</u> (length) (depth to top) <u>2 1/2</u> <u>PVC</u> (size) (material) (6) pump <u>2</u> <u>4</u> (HP) (yield gpm) (type power) (7) electric log <u>yes</u> (yes-or-no) <u>M&S.</u> (organization running log) (8) how well bottom plugged <u>3cuV</u>	<p style="text-align: center;">DEPT. OF NATURAL RESOURCES BUREAU OF LAND & WATER RESOURCES</p> <p style="text-align: right;">NOV 12 1980</p>		
DRILLERS REMARKS:	<p>RECEIVED</p>		

If well telescopes please sketch and show depths.

GROUND LEVEL

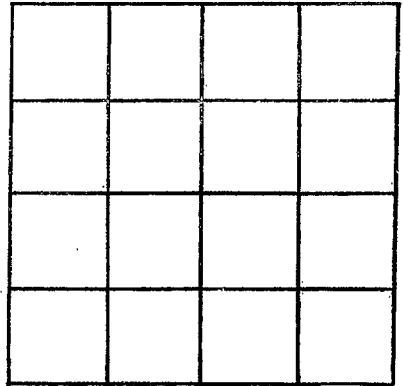

SECTION _____

Please indicate well location X.

ADDITIONAL INFORMATION

If more than one screen,
show locations of each on sketch.